

Well Latitude / Longitude:

40.477673/-104.439622

Flowline Point A (Lat / Long):

40.477685/-104.439602

Flowline Point B (Lat / Long):

40.475794/-104.435350

Flowline Length (ft):


1371

Flowline Abandonment Type:

Full Removal

Comments:

X = Denotes Soil Sample Location

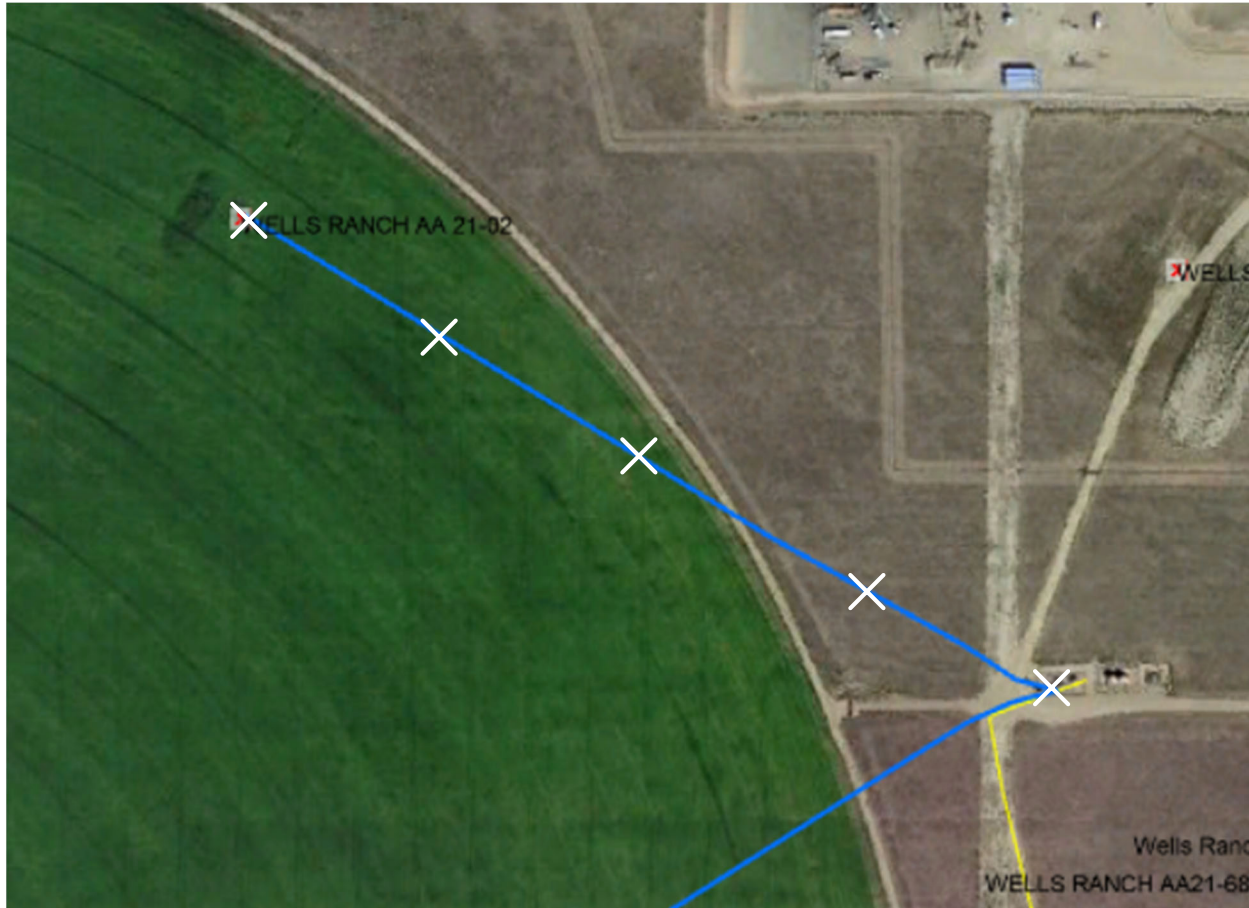

Map Created Date:

11-16-2022

Well Name:

WELLS RANCH AA21-02

Map Created By:

Jeff White

Well API:

05-123-26818

the
human Chevron **energy**
company™