


Big Mountain Viper Figure 1B

Primary Excavation Extents

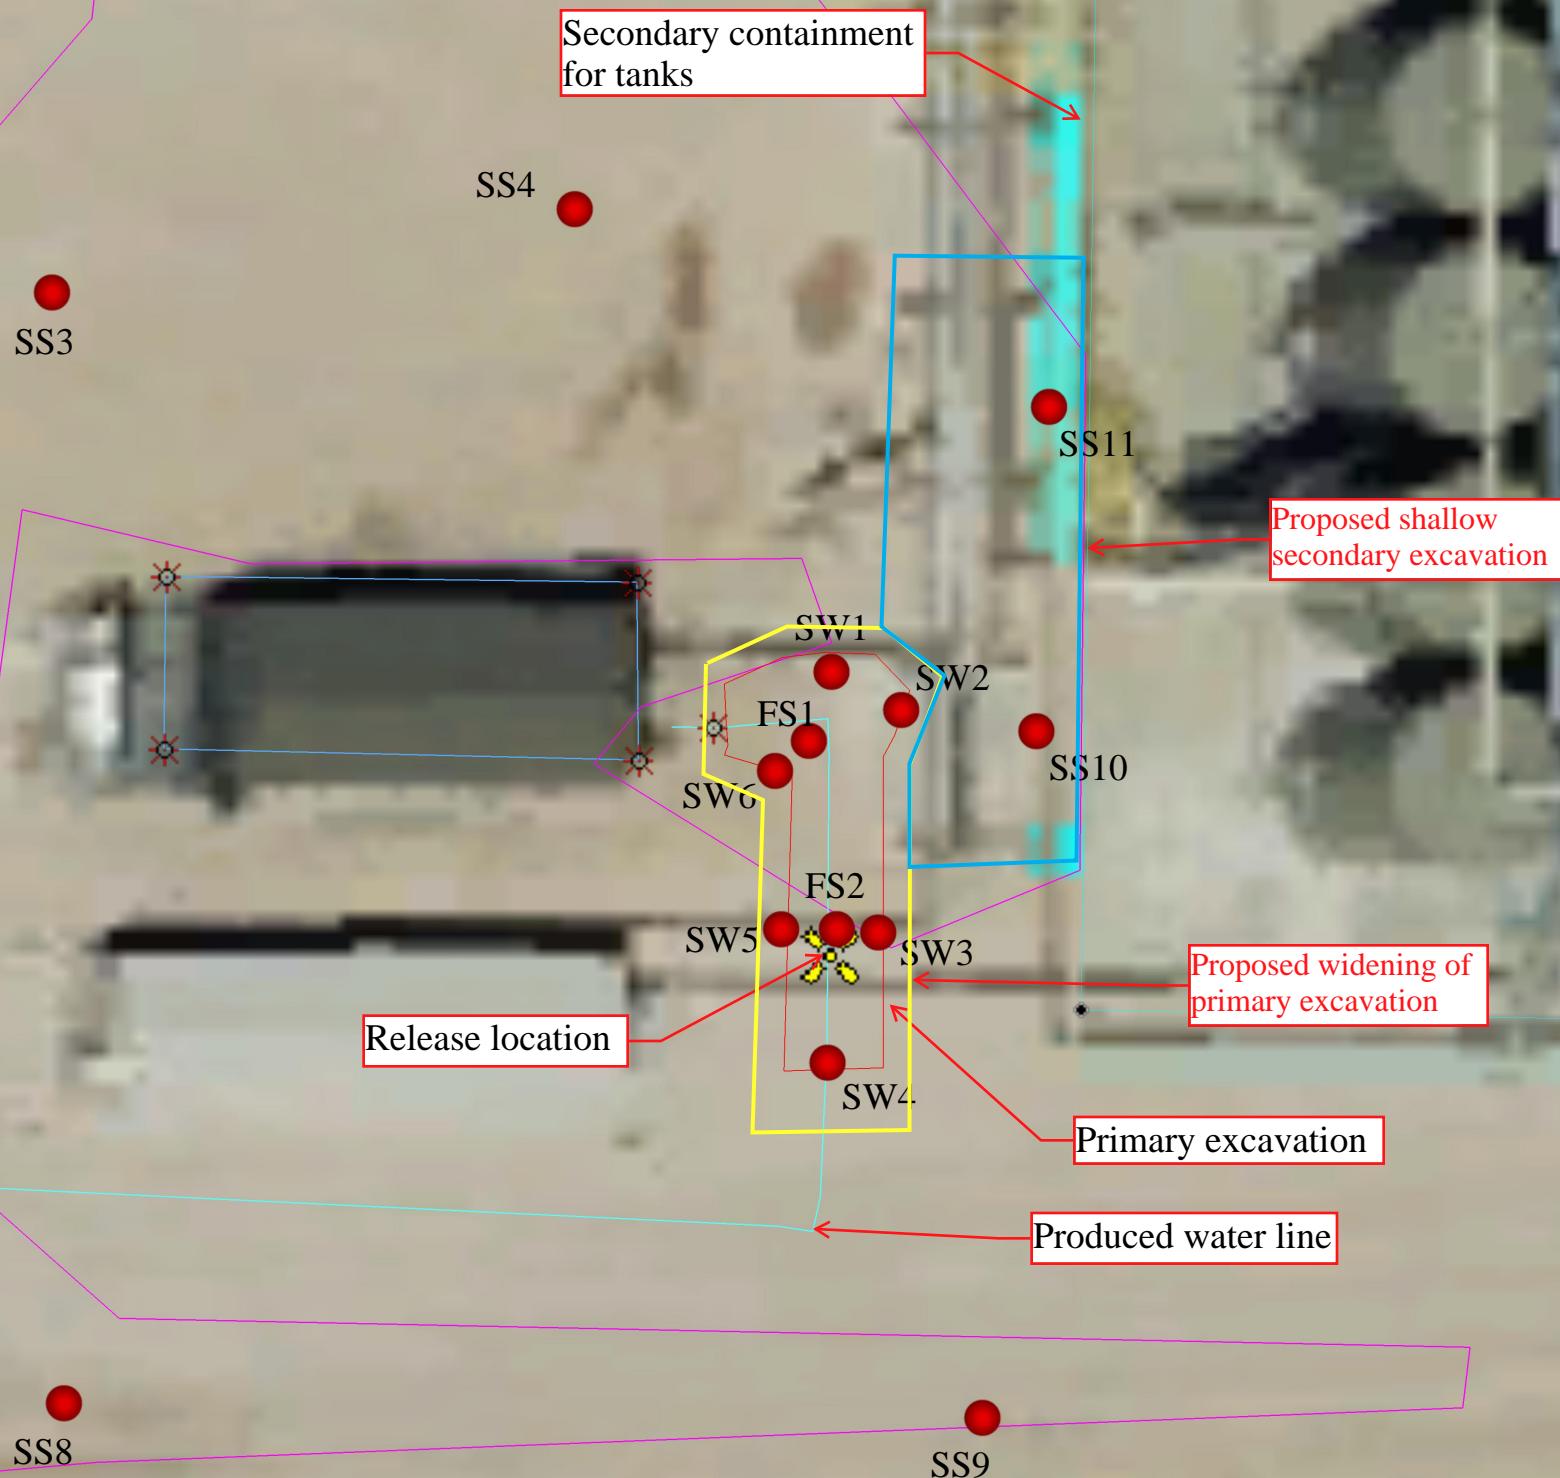

N