



FORM F-106.

RECEIVED


JUN 4 1976

JUN 3 1976

COLO. OIL & GAS CONS. COMM.



R. 59W

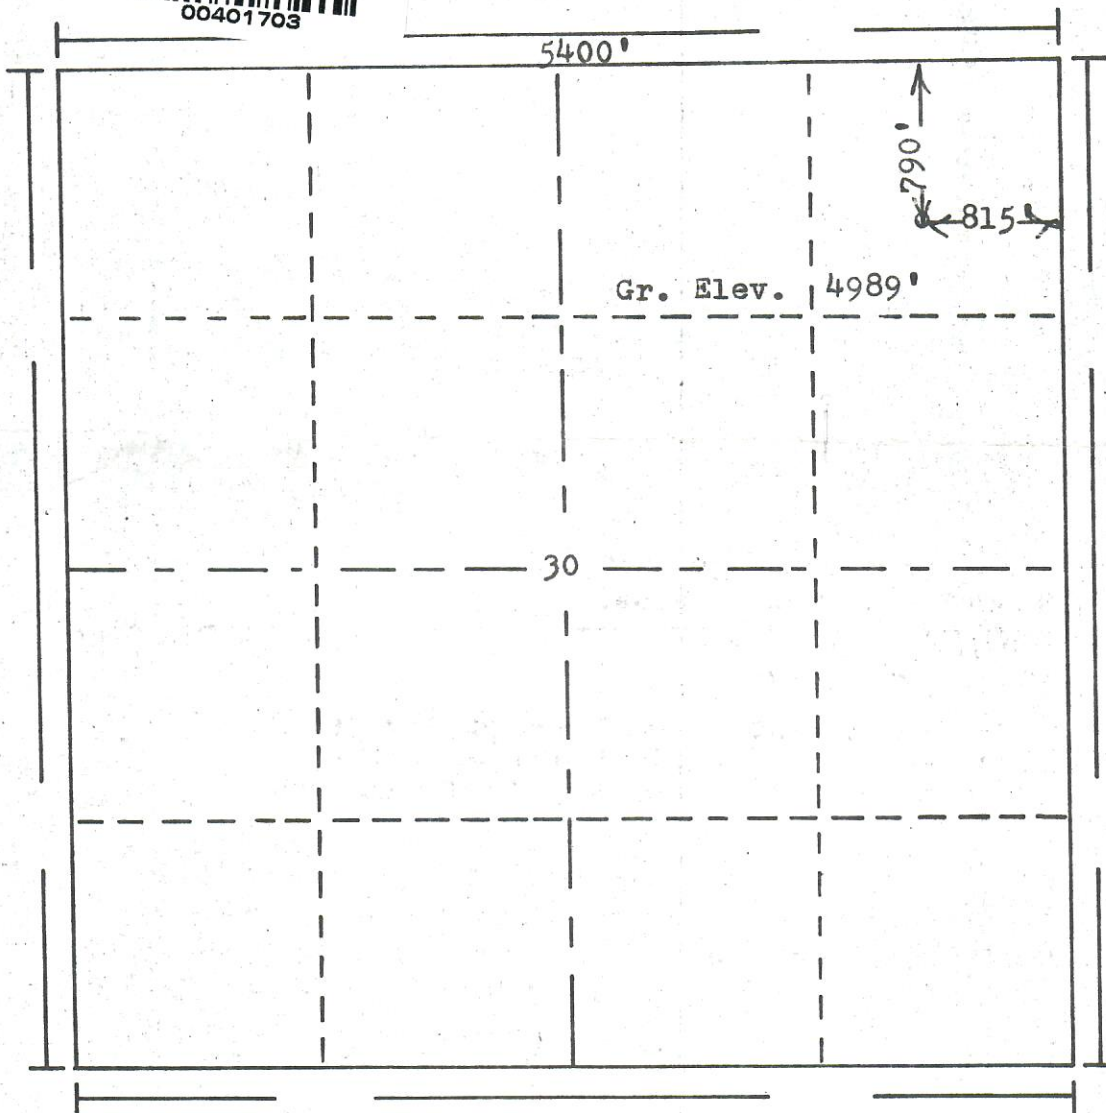

Scale... 1" = 1000'

76-430
Powers Elevation Company, Inc. of Denver, Colorado
has in accordance with a request from Mr. Huckabay
for E. Doyle Huckabay Ltd.

determined the location of No.2 Flader Industries
to be 200'SW of CNE NE Section 30 Township 3S
Range 59W of the 6th Principal Meridian
Adams County, Colorado

I hereby certify that this plat is an
accurate representation of a correct
survey showing the location of

Date: 5-29-76

Bill J. Hollenay
Licensed Land Surveyor No. 2853
State of Colorado