P&A Wellbore For State

Well Name: CALATO G11-23

Land, Original Hole, 12/13/2022 9:09:40 AM

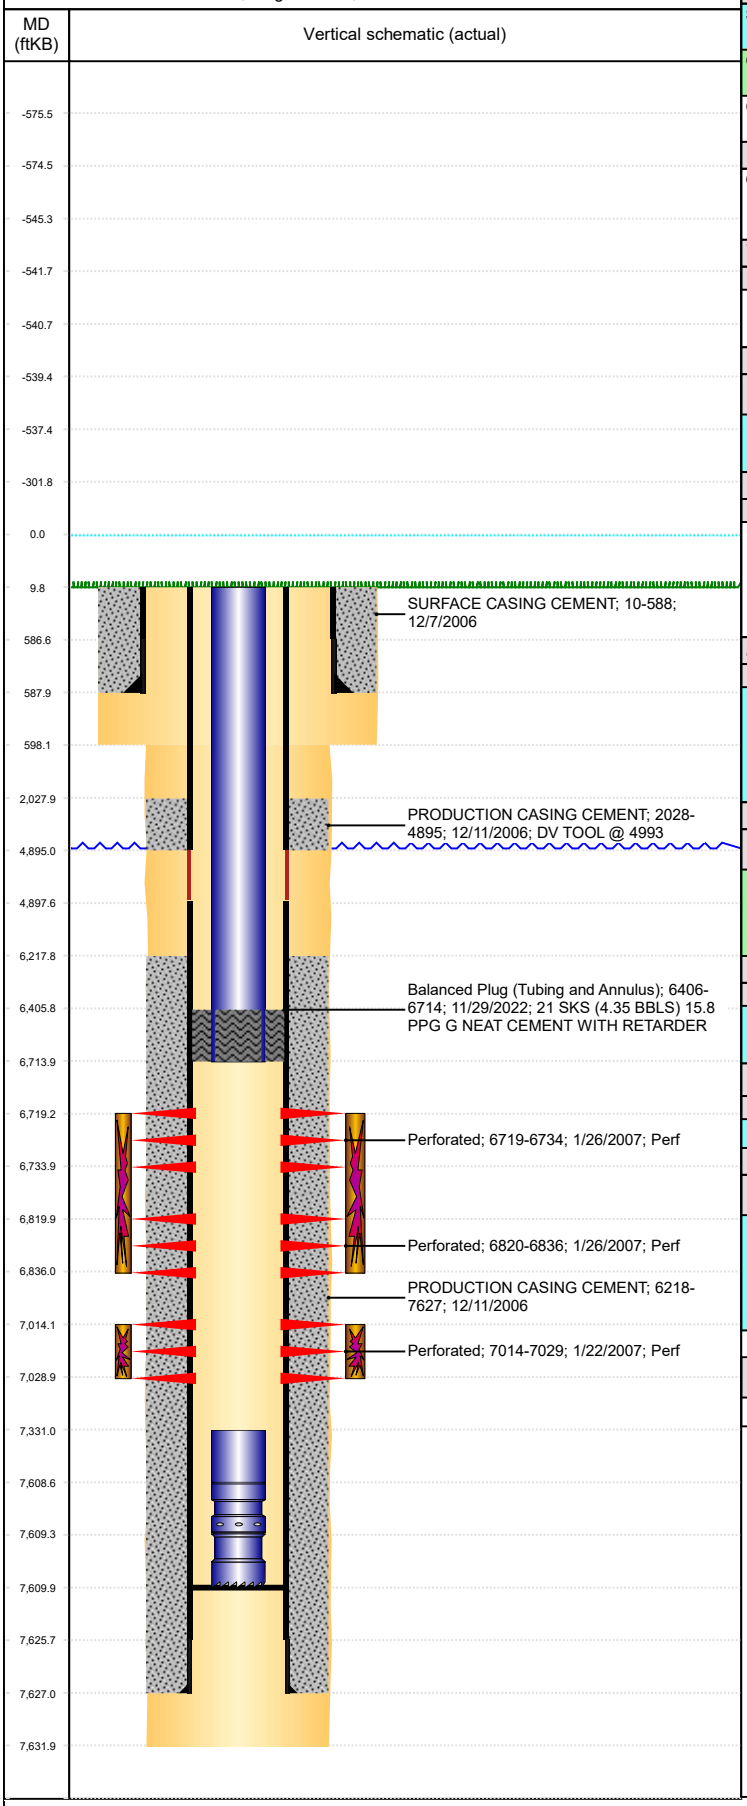

Well Header

Surface UWI	Business Unit	Gov Auth Dist	Prod Tree Loc
0512324381	Rockies		Land

Orig. KB to Gnd (ft)	Original Spud Date	Abandon Date	Well Sub-Status	High…
10.00	12/6/2006		TA	N

Comment
DV TOOL 4895'. PUSHED PLUG TO 7580.5'KB

Surface Location (Congressional)

Qtr 3	Qtr 4	Section	Twnshp	Twnsh…	Range	Rng E/…	Latitude (°)	Longitude (°)
NE	SE	11	4	N	65	W	40.323638283	-104.625544038

Wellbore Sections

Section Des	Hole Size (in)	Act Top (ftKB)	Act Btm (ftKB)
SURFACE	12 1/4	10.0	598.0
PRODUCTION	7 7/8	598.0	7,632.0

Casing Strings

Csg Des	Run Date	OD (in)	Wt/Len (lb/ft)	Grade	Top Depth (MD) (ftKB)	Set Depth (MD) (ftKB)
Surface	12/7/2006	8 5/8	24.00	J-55	10	588
Production Casing	12/11/2006	4 1/2	11.60	M-80	10	7627

Cement

Des	Start Date	Top (ftKB)	Btm (ftKB)
SURFACE CASING CEMENT	12/7/2006	10.0	588.0
PRODUCTION CASING CEMENT	12/11/2006	2,028.0	4,895.0
PRODUCTION CASING CEMENT	12/11/2006	6,218.0	7,627.0
Balanced Plug (Tubing and Annulus)	11/29/2022	6,406.0	6,714.0

Zone Statuses

Zone Name	Status Date	Status	Fluid Type	Job	Prod Method
CODELL	3/2/2007	PR		DRILLING/COMPLETION - ORIGINAL, 12/6/2006…	
CODELL	2/9/2010	PR			Flowing
NIOBRARA	3/2/2007	PR		DRILLING/COMPLETION - ORIGINAL, 12/6/2006…	
NIOBRARA	2/9/2010	PR			Flowing

Perforation Data

Linked Zone	Explosive Type	Entered Shot Total	Top (ftKB)	Btm (ftKB)	Date
NIOBRARA, Original Hole		90	6,719.0	6,734.0	1/26/2007
NIOBRARA, Original Hole		96	6,820.0	6,836.0	1/26/2007
CODELL, Original Hole		60	7,014.0	7,029.0	1/22/2007

Stimulation Intervals

Zone	Start Date	Top (ftKB)	Btm (ftKB)
NIOBRARA, Original Hole	1/26/2007	6,719.0	6,836.0
CODELL, Original Hole	1/26/2007	7,014.0	7,029.0

Other In Hole

Run Date	Des	Make	OD (in)	Top (ftKB)	Btm (ftKB)

Logs

Date	Type	Depth Top (MD) (ftKB)	Btm (ftKB)
12/10/2006	COMPENSATED DENSITY	2,600	7,612.0
12/10/2006	INDUCTION	588	7,632.0
1/22/2007	CBL/CCL/GR	1,905	7,597.0
2/14/2009	MIT TUBING INSPECTION		

Plug Back Total Depths

Date	Type	Com	PBTD (ftKB)
12/11/2006	GUIDE SHOE		7,610