




RECEIVED

DEC 20 1973

COLO. OIL & GAS CONS. COMM.

R. 59W

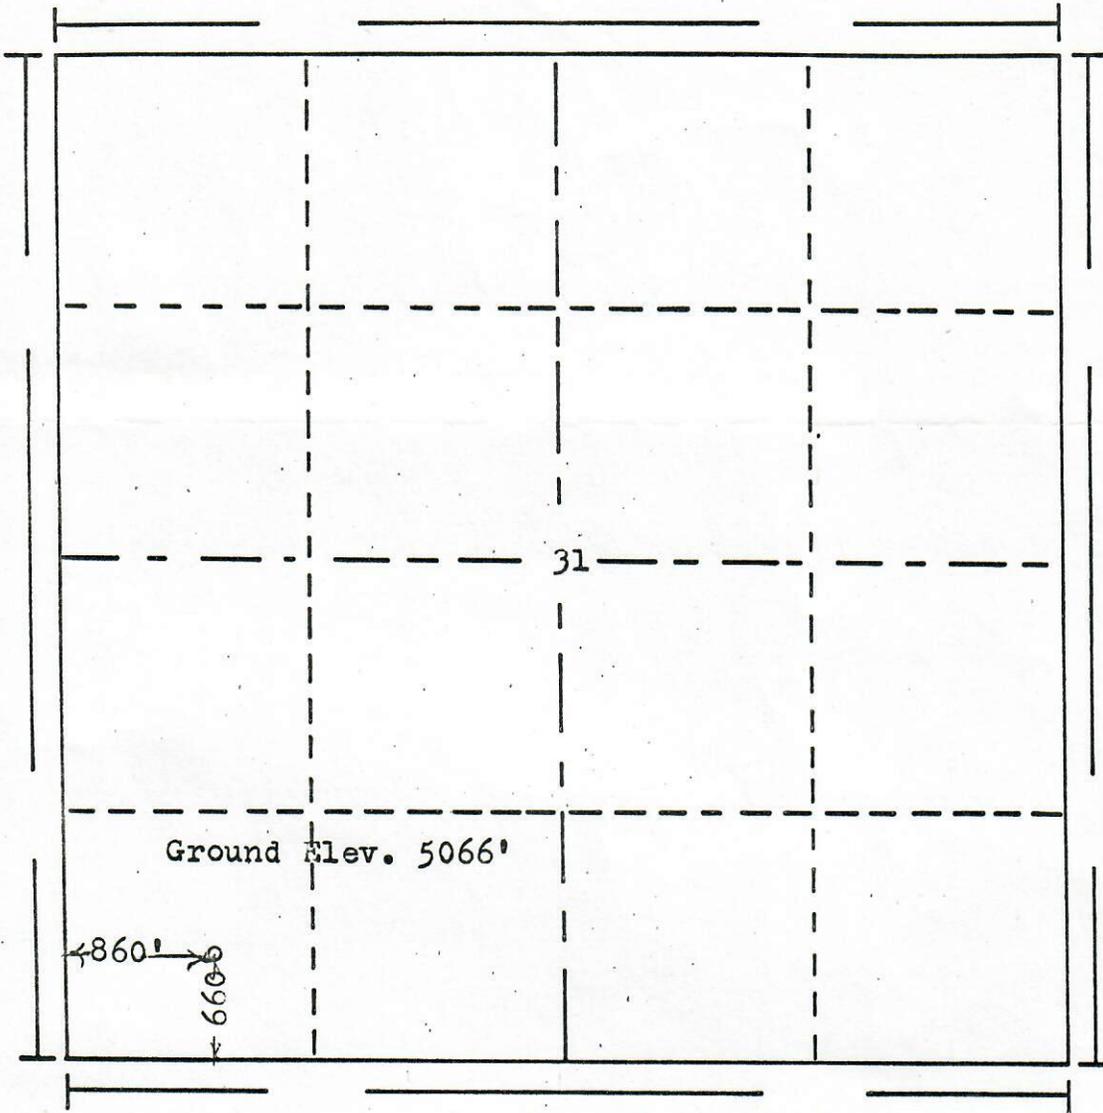

T. 3S

Scale... 1" = 1000'

Powers Elevation Company, Inc. of Denver, Colorado has in accordance with a request from Mr. Huckabay for E. Doyle Huckabay, Ltd.

determined the location of No. 1 Amoco-Maddern to be 660' FS & 860' FW Section 31 Township 3S Range 59W of the 6th Principal Meridian Adams County, Colorado

I hereby certify that this plat is an accurate representation of a correct survey showing the location of

73-1012

Date: 12-12-73

*Bobby J. Hollaway*  
Licensed Land Surveyor No. 2853  
State of Colorado