




RECEIVED

MAR 20 1970

R. 59W

COLO. OIL & GAS CONS. COMM.

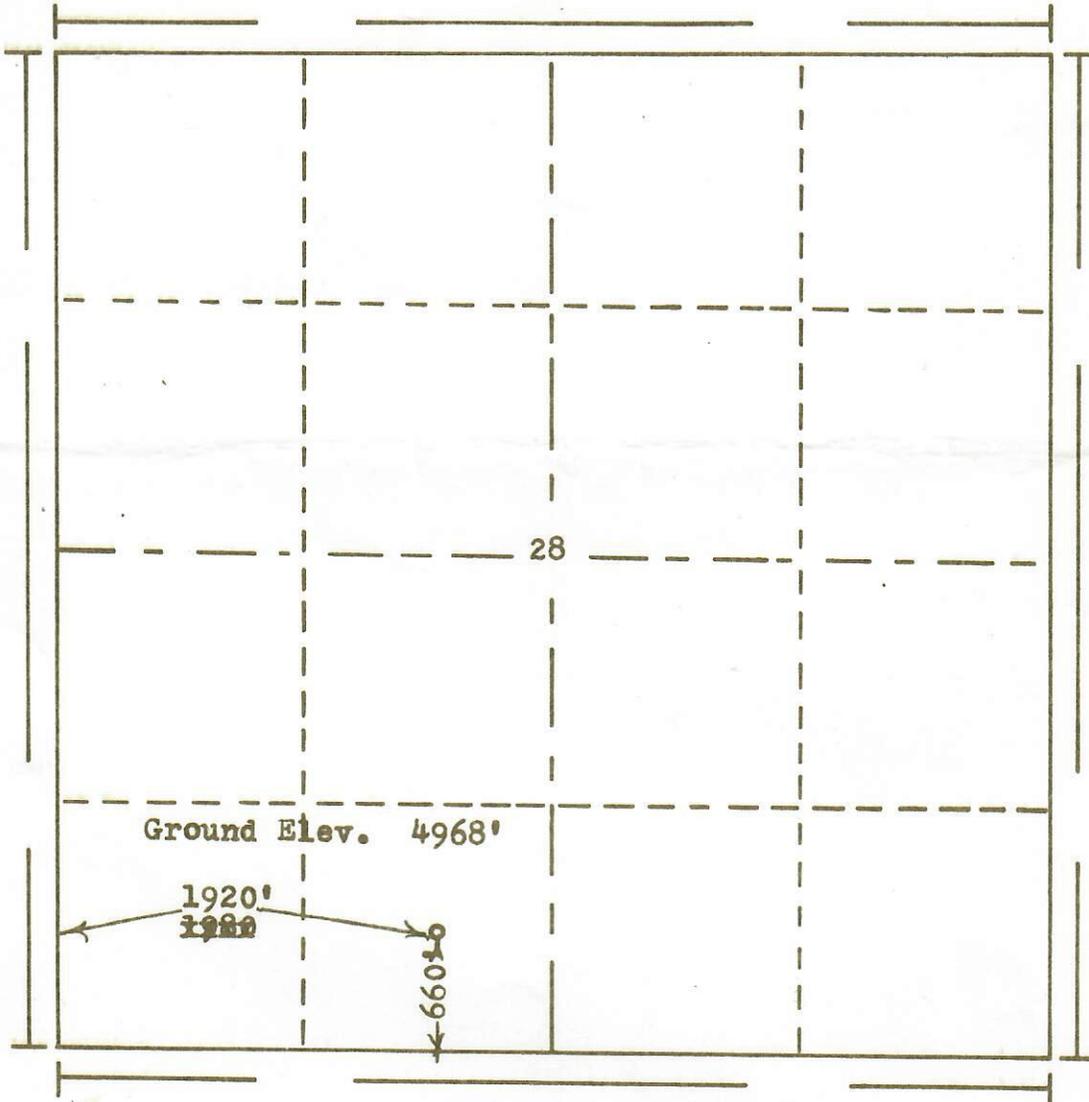

Scale... 1" = 1000'

Powers Elevation Company, Inc. of Denver, Colorado  
 has in accordance with a request from Mr. Snyder  
 for Tom Vessels  
 determined the location of No. 1 <sup>m</sup> Mike Noonan  
 to be CSE SW Section 28 Township 38  
 Range 59W of the 6th Principal Meridian  
Adams County, Colorado

I hereby certify that this plat is an  
 accurate representation of a correct  
 survey showing the location of

Date: 3-16-70

B. J. Hall  
 Licensed Land Surveyor No. 2853  
 State of Colorado

70-104