



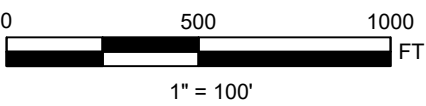

NOTES

****UPDATED AERIAL IMAGERY COLLECTED BY RPG RESOURCES BY USE OF UAV IN DECEMBER 2022****

FIELD OBSERVED DISTURBED AREA: 13.56 ACRES

PERMITTED INT. RECLAMATION AREA: 10.70 ACRES

ACTUAL INT. RECLAMATION AREA: 4.41 ACRES



LEGEND



CROW 3-64 29-30

INTERIM RECLAMATION EXHIBITS

SECTION 29, TOWNSHIP 3 S, RANGE 64 W,
ADAMS COUNTY, COLORADO

SHEET NAME:	SHEET NO.
SITE OVERVIEW	1 OF 3

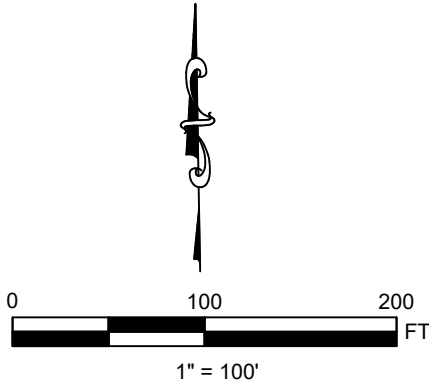


CROW 3-64 29-30
NESE_29_3S_64W

NOTES

UPDATED AERIAL IMAGERY COLLECTED BY RPG RESOURCES BY USE OF UAV IN DECEMBER 2022

FIELD OBSERVED DISTURBED AREA: 13.56 ACRES
PERMITTED INT. RECLAMATION AREA: 10.70 ACRES
ACTUAL INT. RECLAMATION AREA: 4.41 ACRES



LEGEND

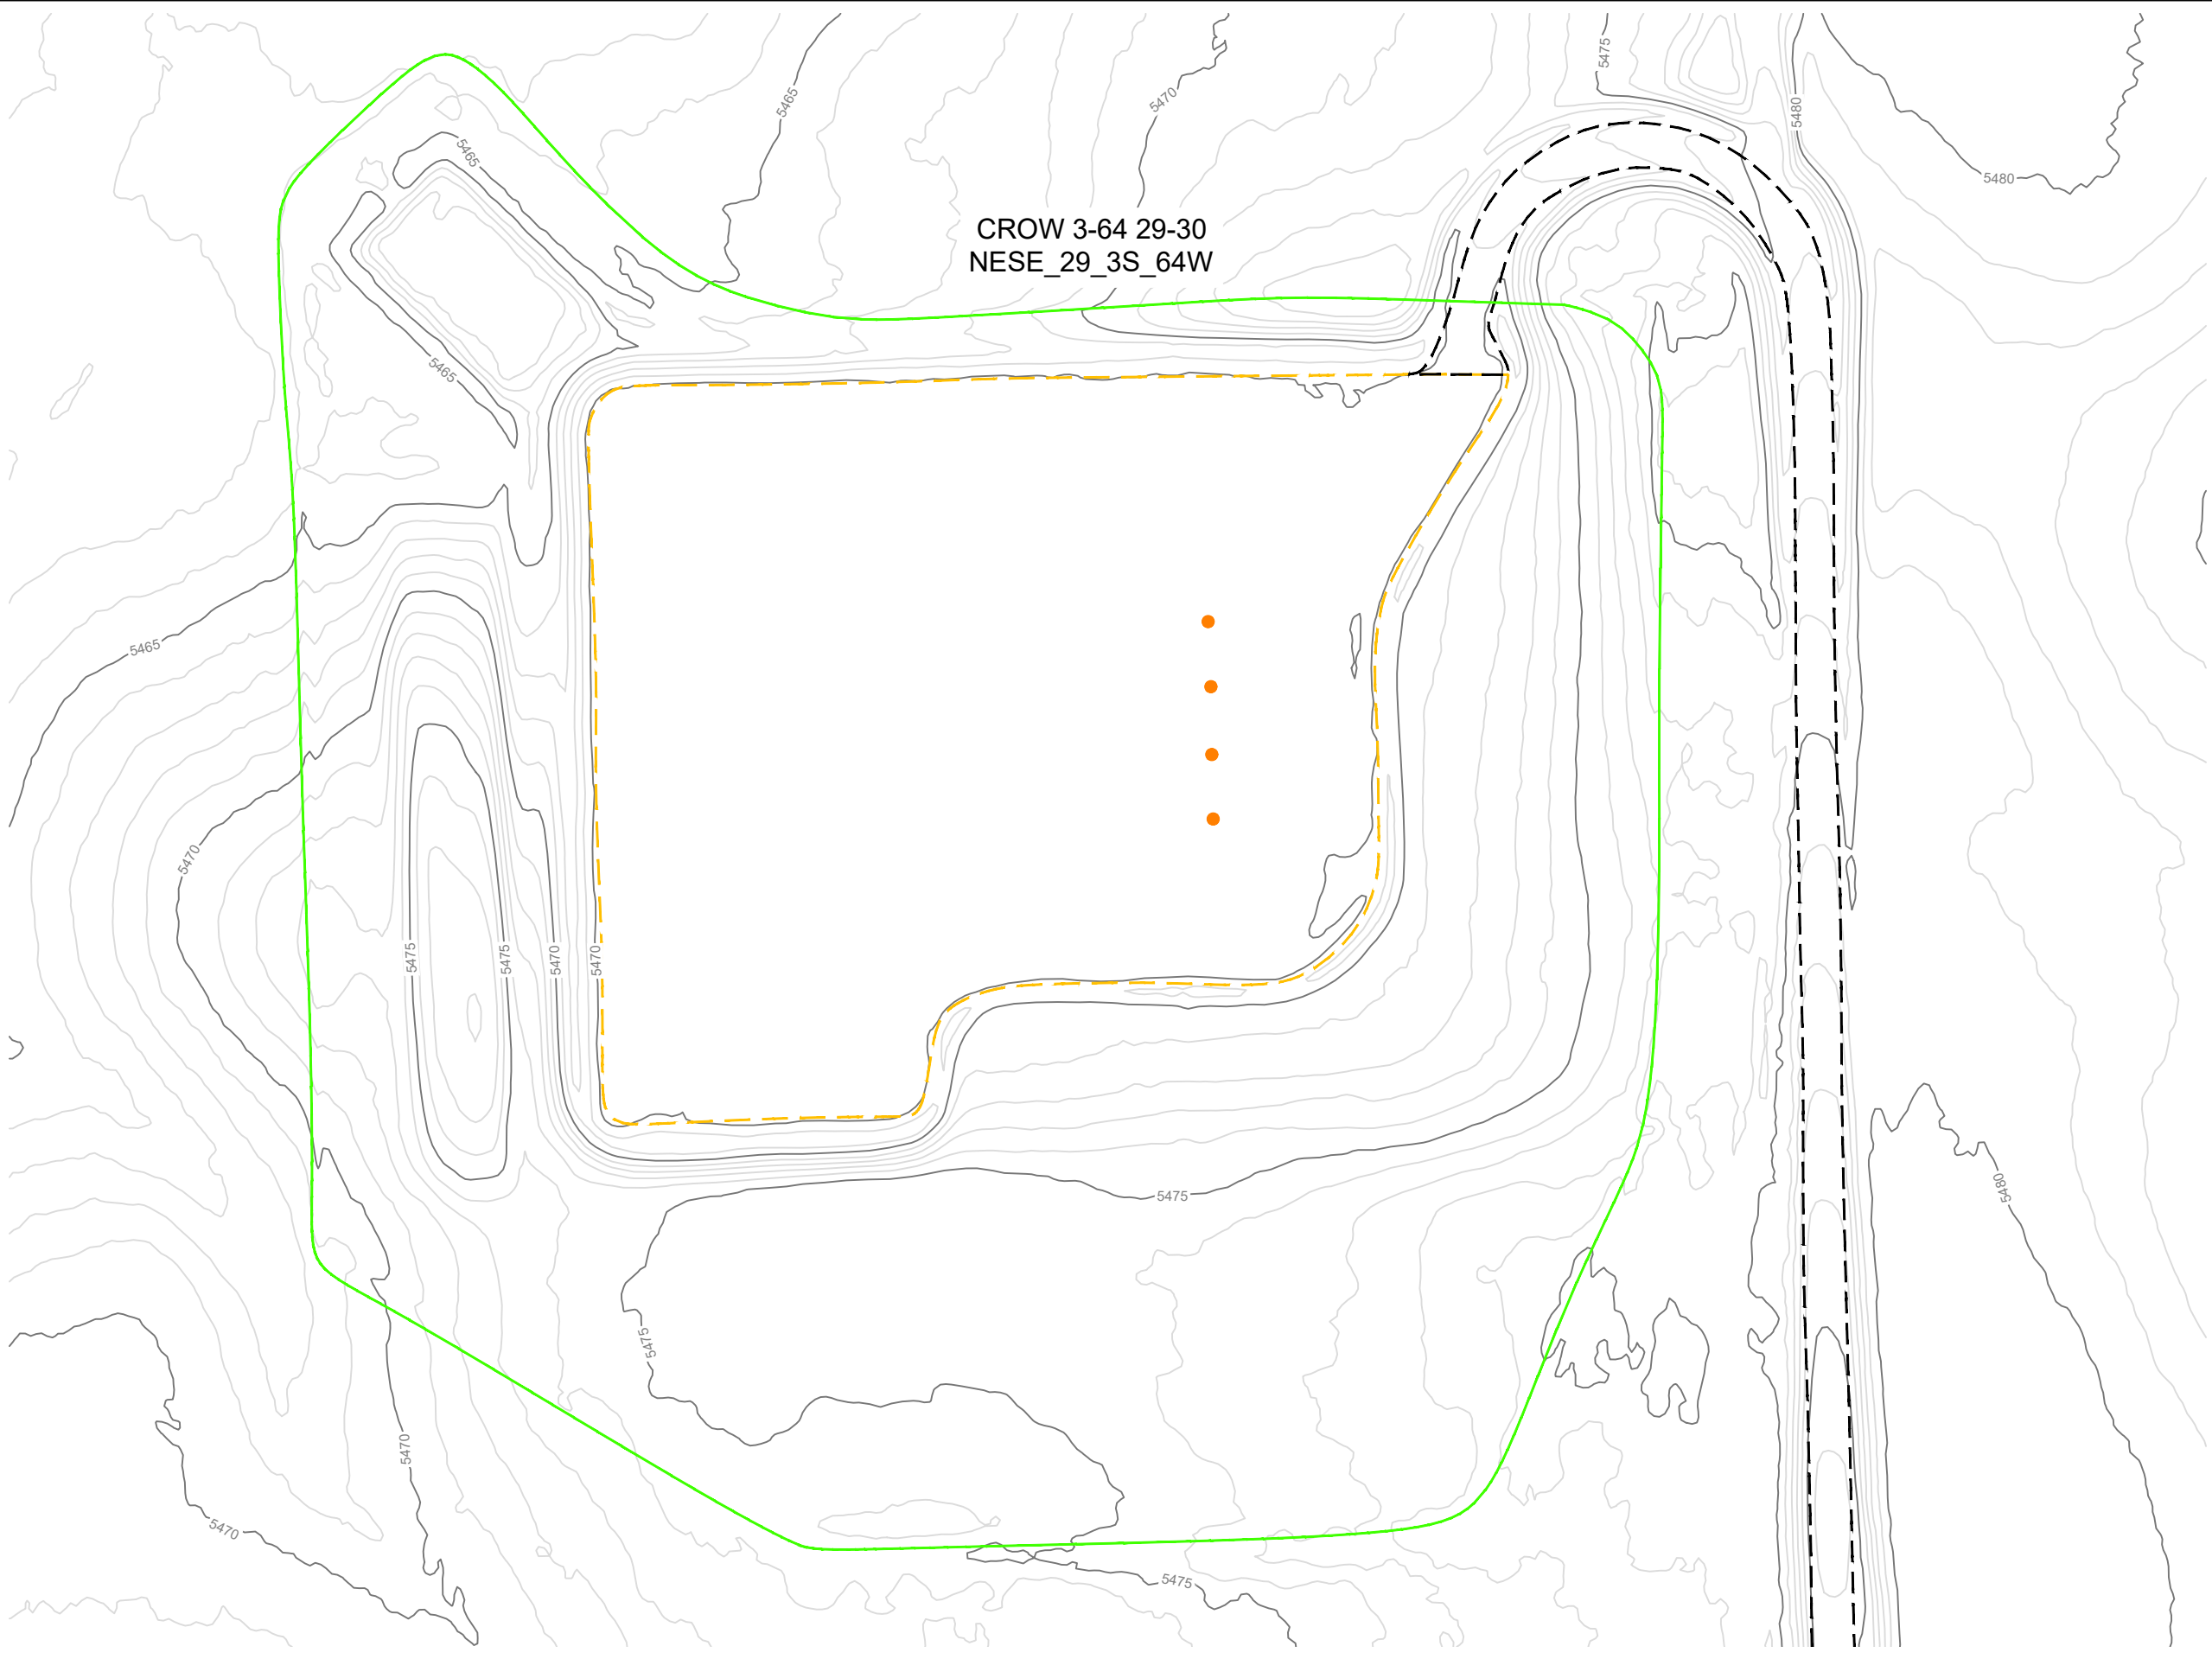
- ACCESS ROAD
- FIELD OBSERVED DISTURBED AREA
- - - ACTUAL INTERIM RECLAMATION AREA
- WELL HEAD



CROW 3-64 29-30
INTERIM RECLAMATION EXHIBITS

SECTION 29, TOWNSHIP 3 S, RANGE 64 W,
ADAMS COUNTY, COLORADO

SHEET NAME:	SHEET NO.
PAD AERIAL	2 OF 3



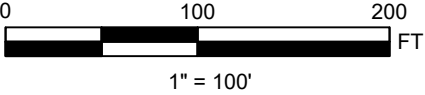

NOTES

****UPDATED TOPOGRAPHY DATA COLLECTED BY
RPG RESOURCES BY USE OF UAV IN DECEMBER
2022****







FIELD OBSERVED DISTURBED AREA: 13.56 ACRES

PERMITTED INT. RECLAMATION AREA: 10.70 ACRES

ACTUAL INT. RECLAMATION AREA: 4.41 ACRES



LEGEND

-  5500 MAJOR CONTOUR
-  MINOR CONTOUR
-  ACCESS ROAD
-  FIELD OBSERVED DISTURBED AREA
-  ACTUAL INTERIM RECLAMATION AREA
-  WELL HEAD



CROW 3-64 29-30

INTERIM RECLAMATION EXHIBITS

SECTION 29, TOWNSHIP 3 S, RANGE 64 W,
ADAMS COUNTY, COLORADO

SHEET NAME:	SHEET NO.
PAD TOPO	3 OF 3