

TUDEX PETROLEUM INC
Freeman 13-2

Op. #90615 LOCATION ID 336189
API #123-13486

Prepared DTA

12/22/2022

COGCC Document No. 0

FIELD NAME
FIELD NUMBER

SPINDLE
77900

Notes:

LOCATION

Basin DENVER - JULESBURG
Location SESW 13 T2N R67W
Elevation 4890

Depth

0 Formation/Member
Topped off from 36' to surface

500 Cut casing at 596', pumped
301 sx stub plug from 650'
to 36', tagged @ 36'

1,000

1,500

2,000


2,500 Perf and squeeze at 2500',
25 sx through, 7 sx on top,
tagged @ 2276'

3,000

3,500

4,000

4,500 CIBP w/ 2 sx @4,411' (75'
above top perf.)
2.375" tubing set at 4,444'
SUSSEX 4,460'-4568

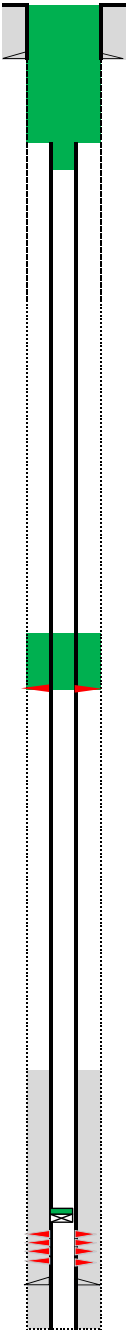

Existing Casing and Cement Coverage

8-5/8", 24 ppf Surface Casing, Set at 480'
cemented w/ 350 sx in 12-1/4" hole

SB5=547'
Deepest DWR w/in 1 mi.=540'

TOC = 3,976'

Production Perfs @ 4,486'-4,527'

4,651' Prod. Casing, 4-1/2", 11.6 ppf
Cemented with 130 sx in 7.875" hole
MDTD 4780'

Depth

0 Plug Placement

500 Cut 4-1/2" casing at
600' 200 sx stub plug
from 650' to surface

1,000

1,500

2,000

2,500 100' Perf and squeeze
at 2500'
25 sx through and 7
sx bal. plug inside
4.5" casing

3,000

3,500

4,000 CBL Required from
top of bridge plug to
surface.

4,500 CIBP w/ 2 sx @4,411'
(75' above top perf.)

