


WELL NAME:	Launer 26W-15-3N					OPERATOR:	Extraction Oil & Gas Inc		
FIELD:	Wattenberg					FORMATION:	Niobrara		
SHL:	qtr-qtr	SESE	Section	26	Township	7N	Range	67W	
BHL:	qtr-qtr	SWSE	Section	27	Township	7N	Range	67W	
COUNTY:	Weld		STATE:	CO		API:	05-123-45175		

not to scale	
GROUND LEVEL:	4928'
KELLY BUSHING:	4953'
SPUD DATE:	11/6/2017
TD DATE:	12/13/2017

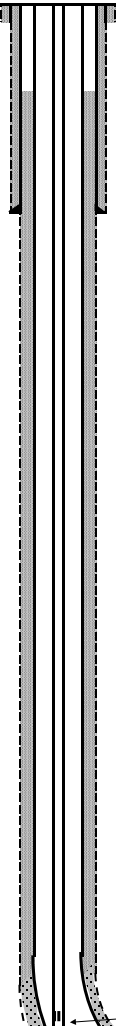

CONDUCTOR CASING	
SIZE:	16"
WEIGHT:	42#
HOLE SIZE:	24"
CSG DEPTH:	80'

SURFACE CASING	
SIZE:	9 5/8"
WEIGHT:	36#
HOLE SIZE:	13 1/2"
HOLE DEPTH:	1554'
CSG DEPTH:	1554'
CEMENT:	550 sx
TOC:	Surface

PRODUCTION CASING	
SIZE:	5 1/2"
WEIGHT:	20#
HOLE SIZE:	8 1/2"
TOTAL DEPTH TVD	6887'
TOTAL DEPTH MD	14800'
CSG DEPTH:	14786'
CEMENT:	2330 sx
TOC:	508'

PRODUCTION TUBING	
SIZE:	2 3/8"
WEIGHT:	--
DEPTH:	7451'
PACKER DEPTH:	7437'

FRAC DATA

327	BBLS ACID
19,835	BBLS FRESH WATER
20,162	BBLS TOTAL FLUID

FORMATION TOPS & PERFORATIONS	
NIOBRARA MD	7365'

PERFORATIONS	7635'-14736'
--------------	--------------

3,664,050	# 40/70 MESH
10,736,140	# 30/50 MESH
14,400,190	# TOTAL SAND

EOT @ 7451'

Production Csg @ 14786'

MD TD 14800'

48 47 46 45 44 43 42 41 40 39 38 37 36 35 34 33 32 31 30 29 28 27 26 25 24 23 22 21 20 19 18 17 16 15 14 13 12 11 10 9 8 7 6 5 4 3 2 1