




RECEIVED

MAR 31 1971

COLO. OIL & GAS CONS. COMM.

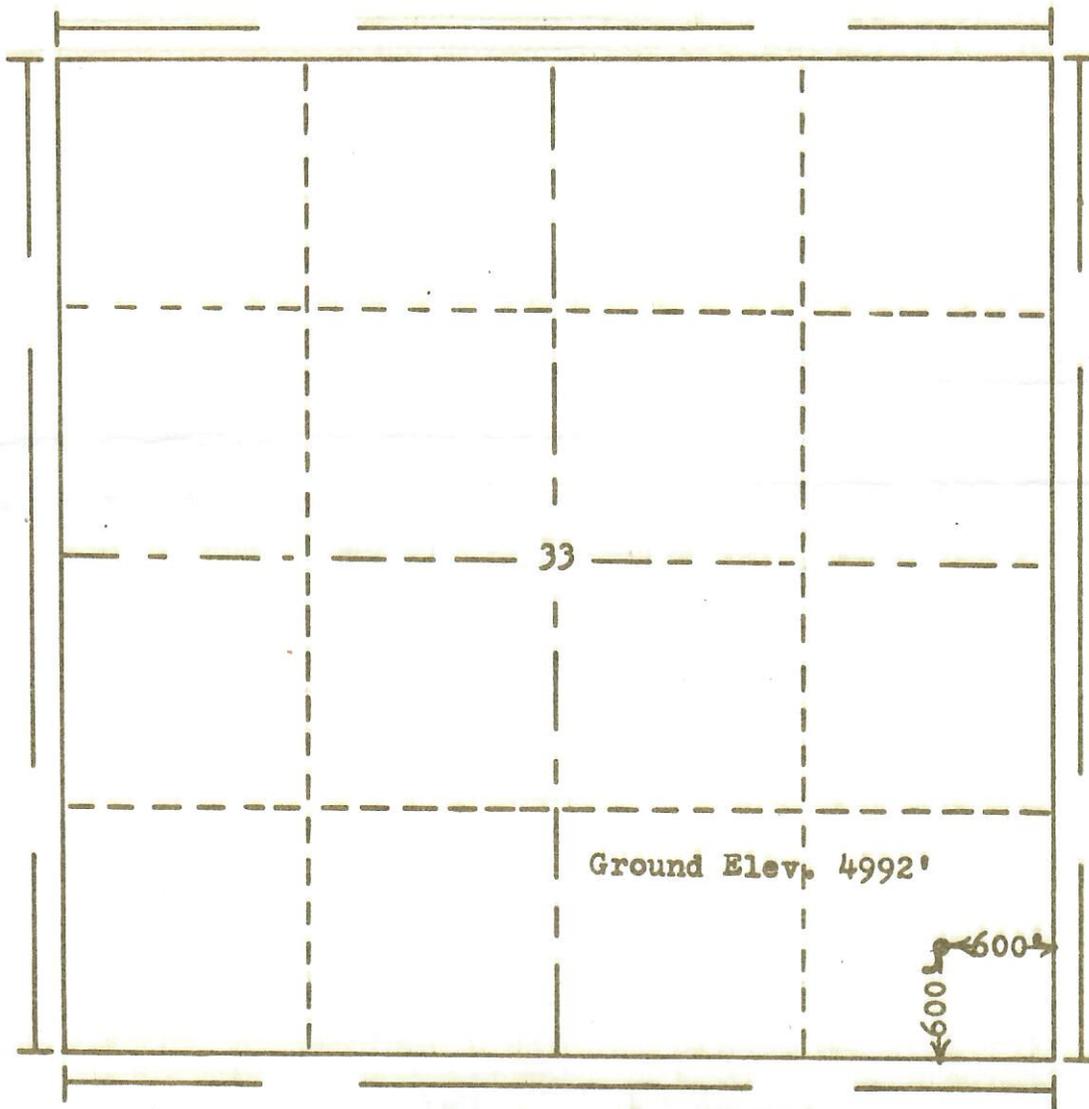

Scale... 1" = 1000'

Powers Elevation Company, Inc. of Denver, Colorado
 has in accordance with a request from Mr. Durr
 for Edward Mike Davis
 determined the location of No.1 UPRR-Price
 to be 600'FS & 600'FE Section 33 Township 33
 Range 59W of the 6th Principal Meridian
 Adams County, Colorado

I hereby certify that this plat is an
 accurate representation of a correct
 survey showing the location of

Date: 3-23-71

Bob G. Henry
 Licensed Land Surveyor No. 2853
 State of Colorado