

CERTIFICATE OF SURVEY
for
Tiger Oil Co.
Adams County, Colorado


RECEIVED

OCT 21 1971

COLO. OIL &



T3S R59W 6PM

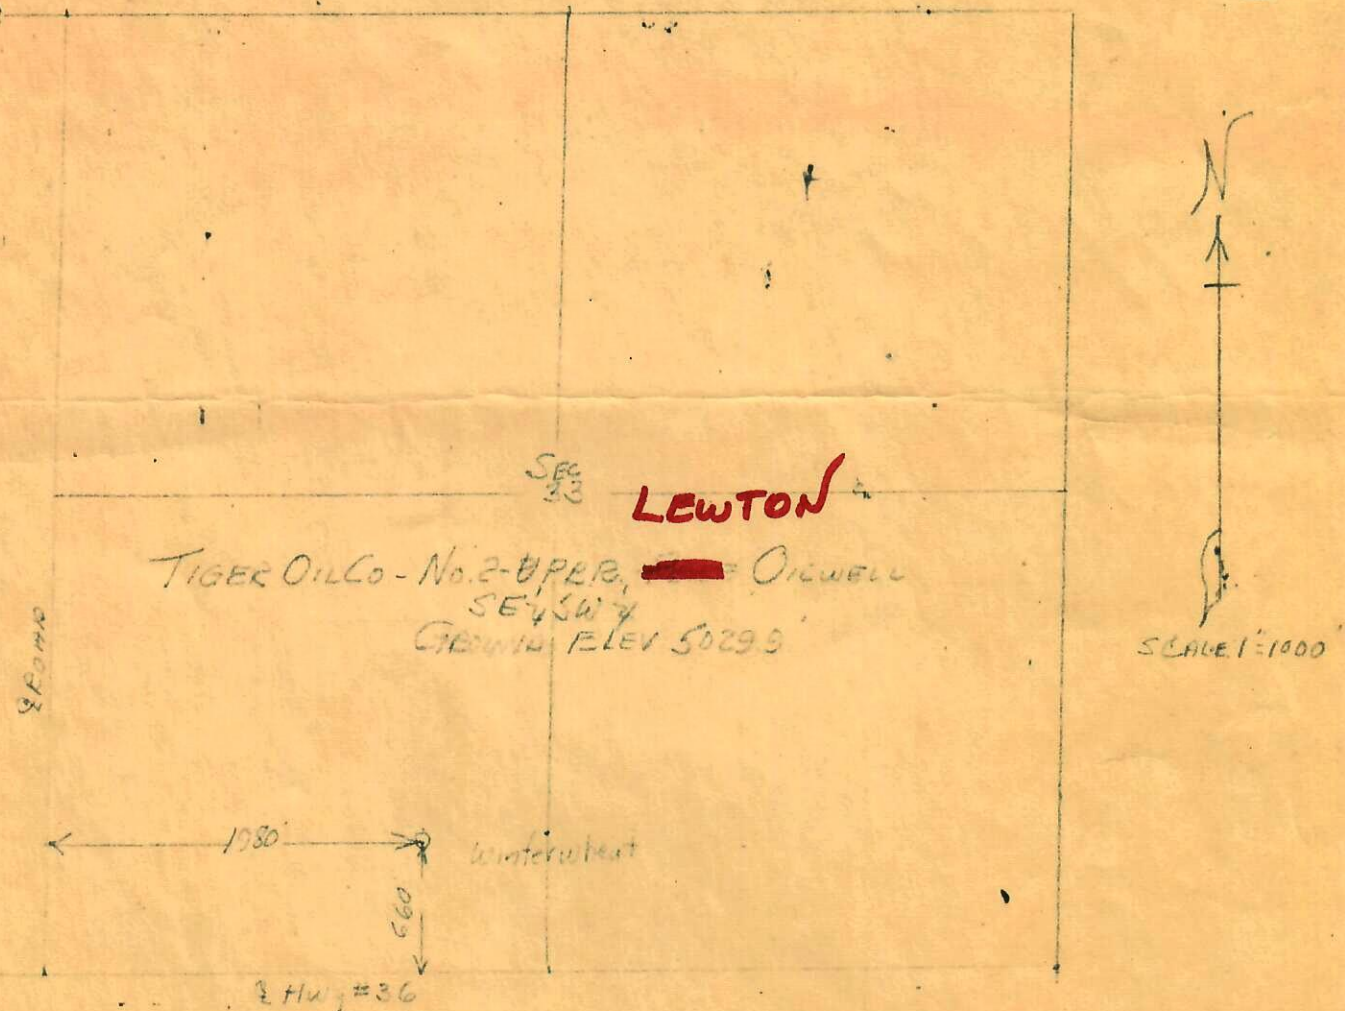

I hereby certify that the above plat is an accurate representation of a correct survey showing the location of Tiger Oil Co.-No.2 U.P.R.R. Price Oilwell in SE 1/4 SW 1/4 Sec.33 T3S R59W 6PM. The elevation of the ground at the stake is 5029.9 feet above sea level from U.S.G.S. Bench Mark.

Fort Morgan, Colorado
October 12, 1971

Abel J. Osborne
Registered Professional Engineer
State of Colorado

71-780