MD (ftKB)	TVD (ftKB)	Incl (°)
24.0	24.0	0.0
74.1	74.1	0.0
126.0	126.0	0.0
2,243.8	2,089.9	32.0
2,270.0	2,112.2	32.4
2,329.7	2,162.5	33.5
2,373.4	2,198.6	34.4
2,390.1	2,212.5	34.7
2,423.9	2,240.4	34.8
2,840.9	2,602.1	25.0
3,579.1	3,298.7	16.1
3,582.0	3,301.5	16.1
3,733.9	3,448.6	12.6
4,084.0	3,791.1	11.4
4,134.8	3,841.0	11.1
5,613.8	5,306.1	6.2
5,803.1	5,494.4	6.0
5,841.9	5,532.9	6.0
6,014.4	5,704.5	5.9
6,068.9	5,758.7	5.6
6,120.1	5,809.7	5.0
9,063.0	8,743.6	7.3
9,366.1	9,044.3	7.7
9,367.1	9,045.2	7.7
9,410.8	9,088.5	7.7
9,428.1	9,105.7	7.7
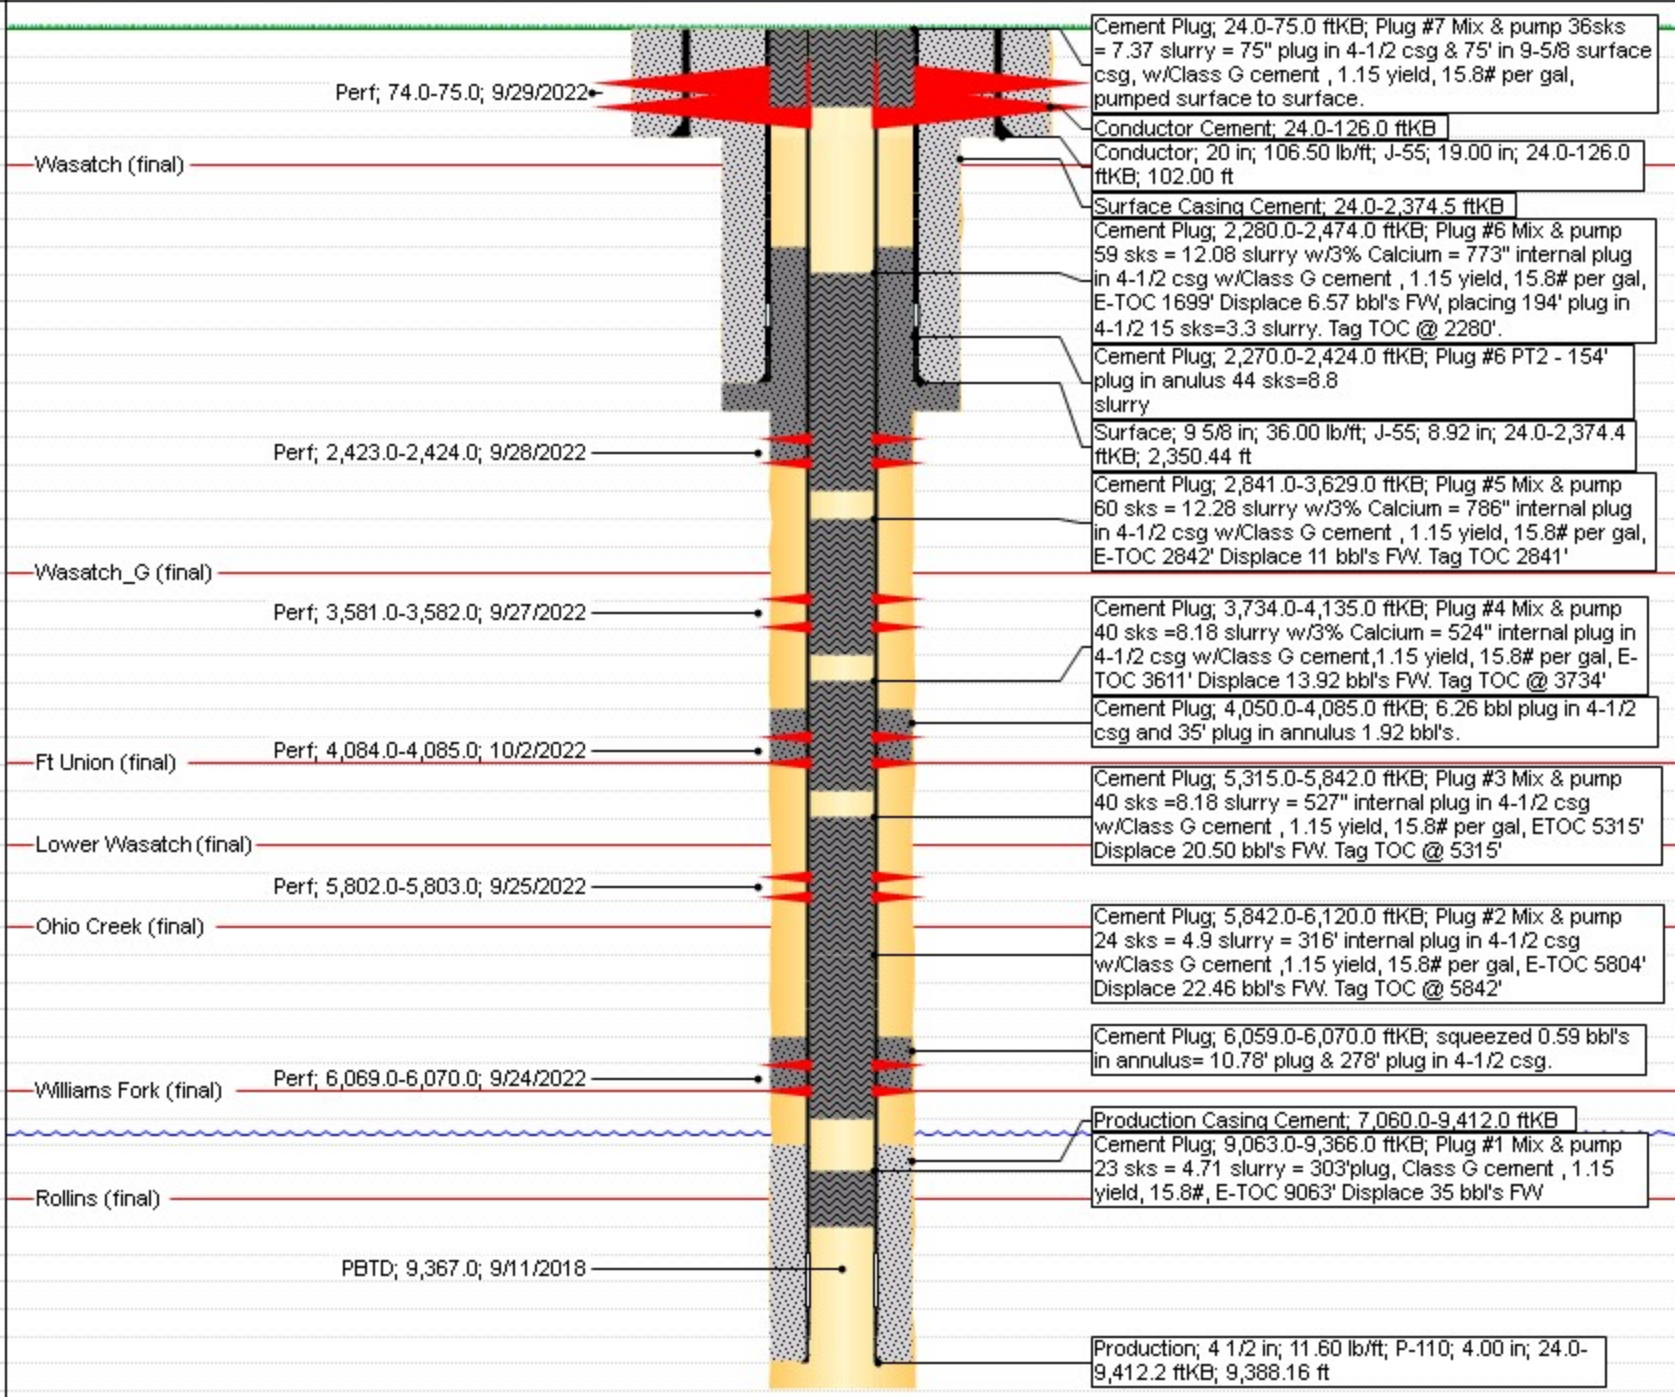
Vertical schematic (actual)