



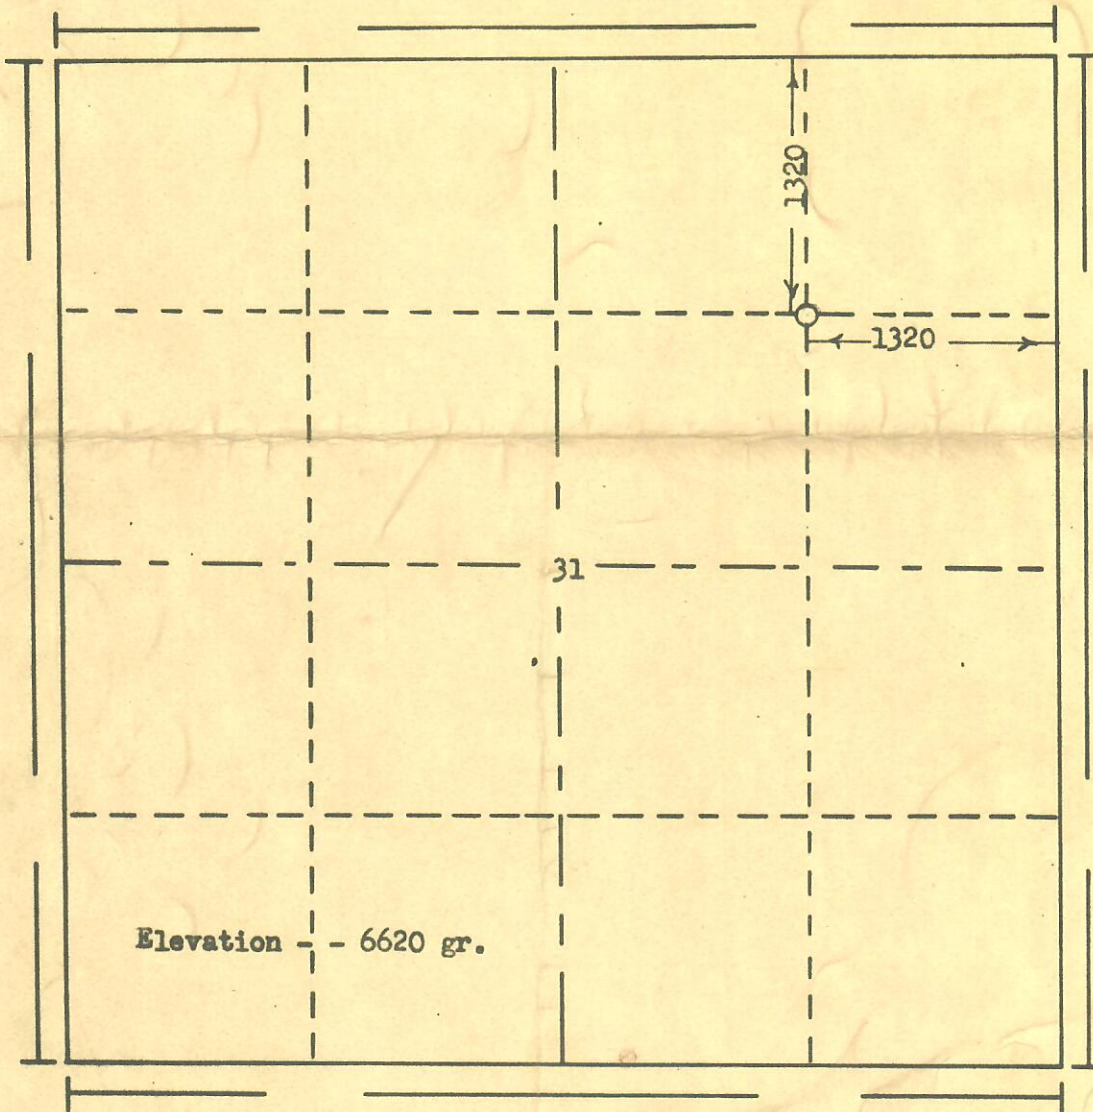
00250271

RECEIVED

MAY 29 1969

COLO. OIL &amp; GAS CONS. COMM.

R. 90 W

T.  
8  
N

Scale... 1" = 1000'

Powers Elevation Company, Inc. of Denver, Colorado  
has in accordance with a request from Mr. Thomas  
for Sun Oil Company  
determined the location of # A-1 W. W. McWilliams  
to be 1320FN & 1320FE Section 31 Township 8 N  
Range 90 W of the Sixth Principal Meridian  
Moffat County, Colorado

I hereby certify that this plat is an  
accurate representation of a correct  
survey showing the location of  
# A-1 W. W. McWilliams

Date: 5-21-69

*Joseph F. Faycock*  
Licensed Land Surveyor No. 485  
State of Wyoming

