

OIL AND GAS CONSERVATION COMMISSION OF THE STATE OF COLORADO

RECEIVED OCT 31 1957 OIL & GAS CONSERVATION COMMISSION

NOTICE OF INTENTION TO DRILL


INSTRUCTIONS:

A notice of intention to drill a well shall be filed in duplicate on all Federal and Patented lands, and in triplicate on all State lands. Do not begin operations until approved copy has been received. It is mandatory that the proposed location comply with all rules and regulations of the Commission. Locate well on section grid in proper location, and indicate extent of lease. Unless operations are commenced within 180 days after the date of approval hereof, this approval to drill will become null and void.

Name of Operator Plains Exploration Company Phone No. CH 4-7431
Address 1135 Petroleum Club Bldg. City Denver 2 State Colo.

How is liability secured: Well Bond (Attached) []; Blanket Bond []; Waiver [X] (Check one)

Lease Name R. B. Smoot
Well No. # 1
Field Name Pierce Wildcat []
County Weld

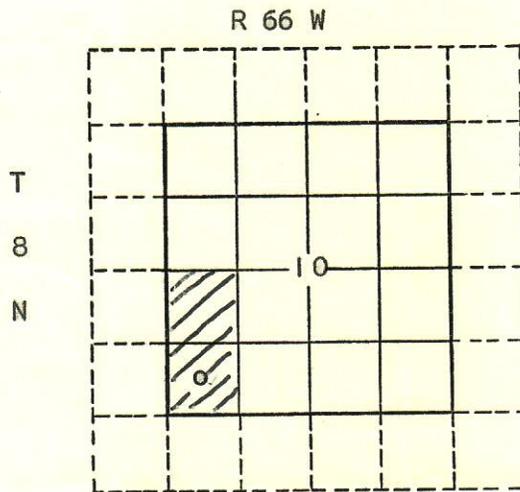

Location C SW SW Section 10 Township 8 N Range 66 W Meridian 6th
660 feet from S Section line and 660 feet from W Section Line

The well is located on: Patented land [X] State land [] Federal land []

The well is located within a spaced area: Yes [X] No []

Distance from proposed location to nearest property or lease line 660 feet.
Distance from proposed location to nearest drilling unit line N-A feet.

Objectives: "J" Sand-Dakota Formation Depth 7970 Estimate; Lyons Formation Depth 9280 Estimate

Proposed length of surface casing 500 feet. of 10 3/4" surface casing with 350 sacks cement.

REMARKS: Estimated T. D. - 9430'.
Ground Elev. - 5108'.

Table with columns for Agent, Bond, Date, Well No., Casing, Cement, Status. Includes handwritten signatures and dates.

I/We hereby swear (or affirm) that the statements herein made are a full and correct report.

APPROVED: Date OCT 31 1957
A. J. Gersinow Director

Company Plains Exploration Co. Date Oct. 28th, 1957
Address 1135 Petr. Club Bldg. Phone No. CH 4-7431
By Russell H. Volk Signature Title President