00269346

RECEIVED
NOV - 6 1959
OIL & GAS
CONSERVATION COMMISSION

T 8 N, R 87 W

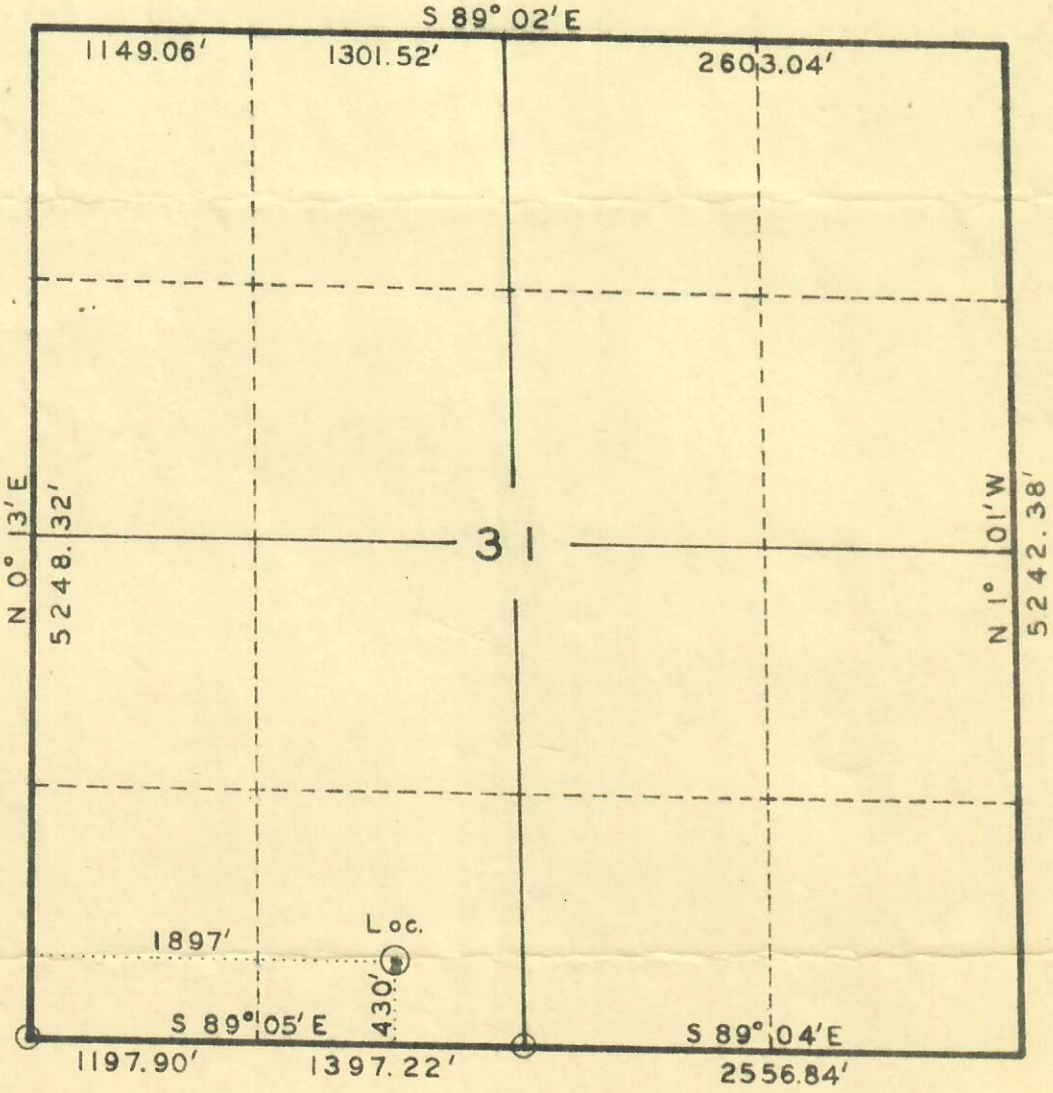

○ - Corners located (brass cap)

Scale: 1" = 1000'

1897
- 1198
699

R. D. Ross

By: ROSS CONSTRUCTION CO.
Vernal, Utah

PARTY R. D. Ross M. R. Slaugh WEATHER Rain- Cold	SURVEY WESTERN DRILLING CO. VINSON WELCH NO. 1 LOCATION, SE/4, SW/4, SECTION 31, T 8 N, R 87 W, 6 TH. P.M., ROUTT COUNTY, COLORADO.	DATE Oct. 27, 1959 REFERENCES U S G L O Survey plat-Approved March 16, 1922 FILE Western Drilling

FORM 5202