CIVITAS

Final Abandon Wellbore Diagram

Well Name: HUYLER 01

Reference Wells	
Type: Deepest Nearby Water Well	Comment: 740
Type: Sussex	Comment: No SSX or SN prd w/n 1 mile

API #	Qtr 1	Qtr 2	Section	Township	Twnshp N/S…	Range	Range E/W Dir	County/Parish	State	Orig KB (ft)	Total Depth (MD) (…	User Num 1
05-123-05173	NW	NW	16	4	S	65	W		CO	0.00	6,632.0	

Well Status	P&A Date
PLUGGED & ABANDONED	12/9/2022
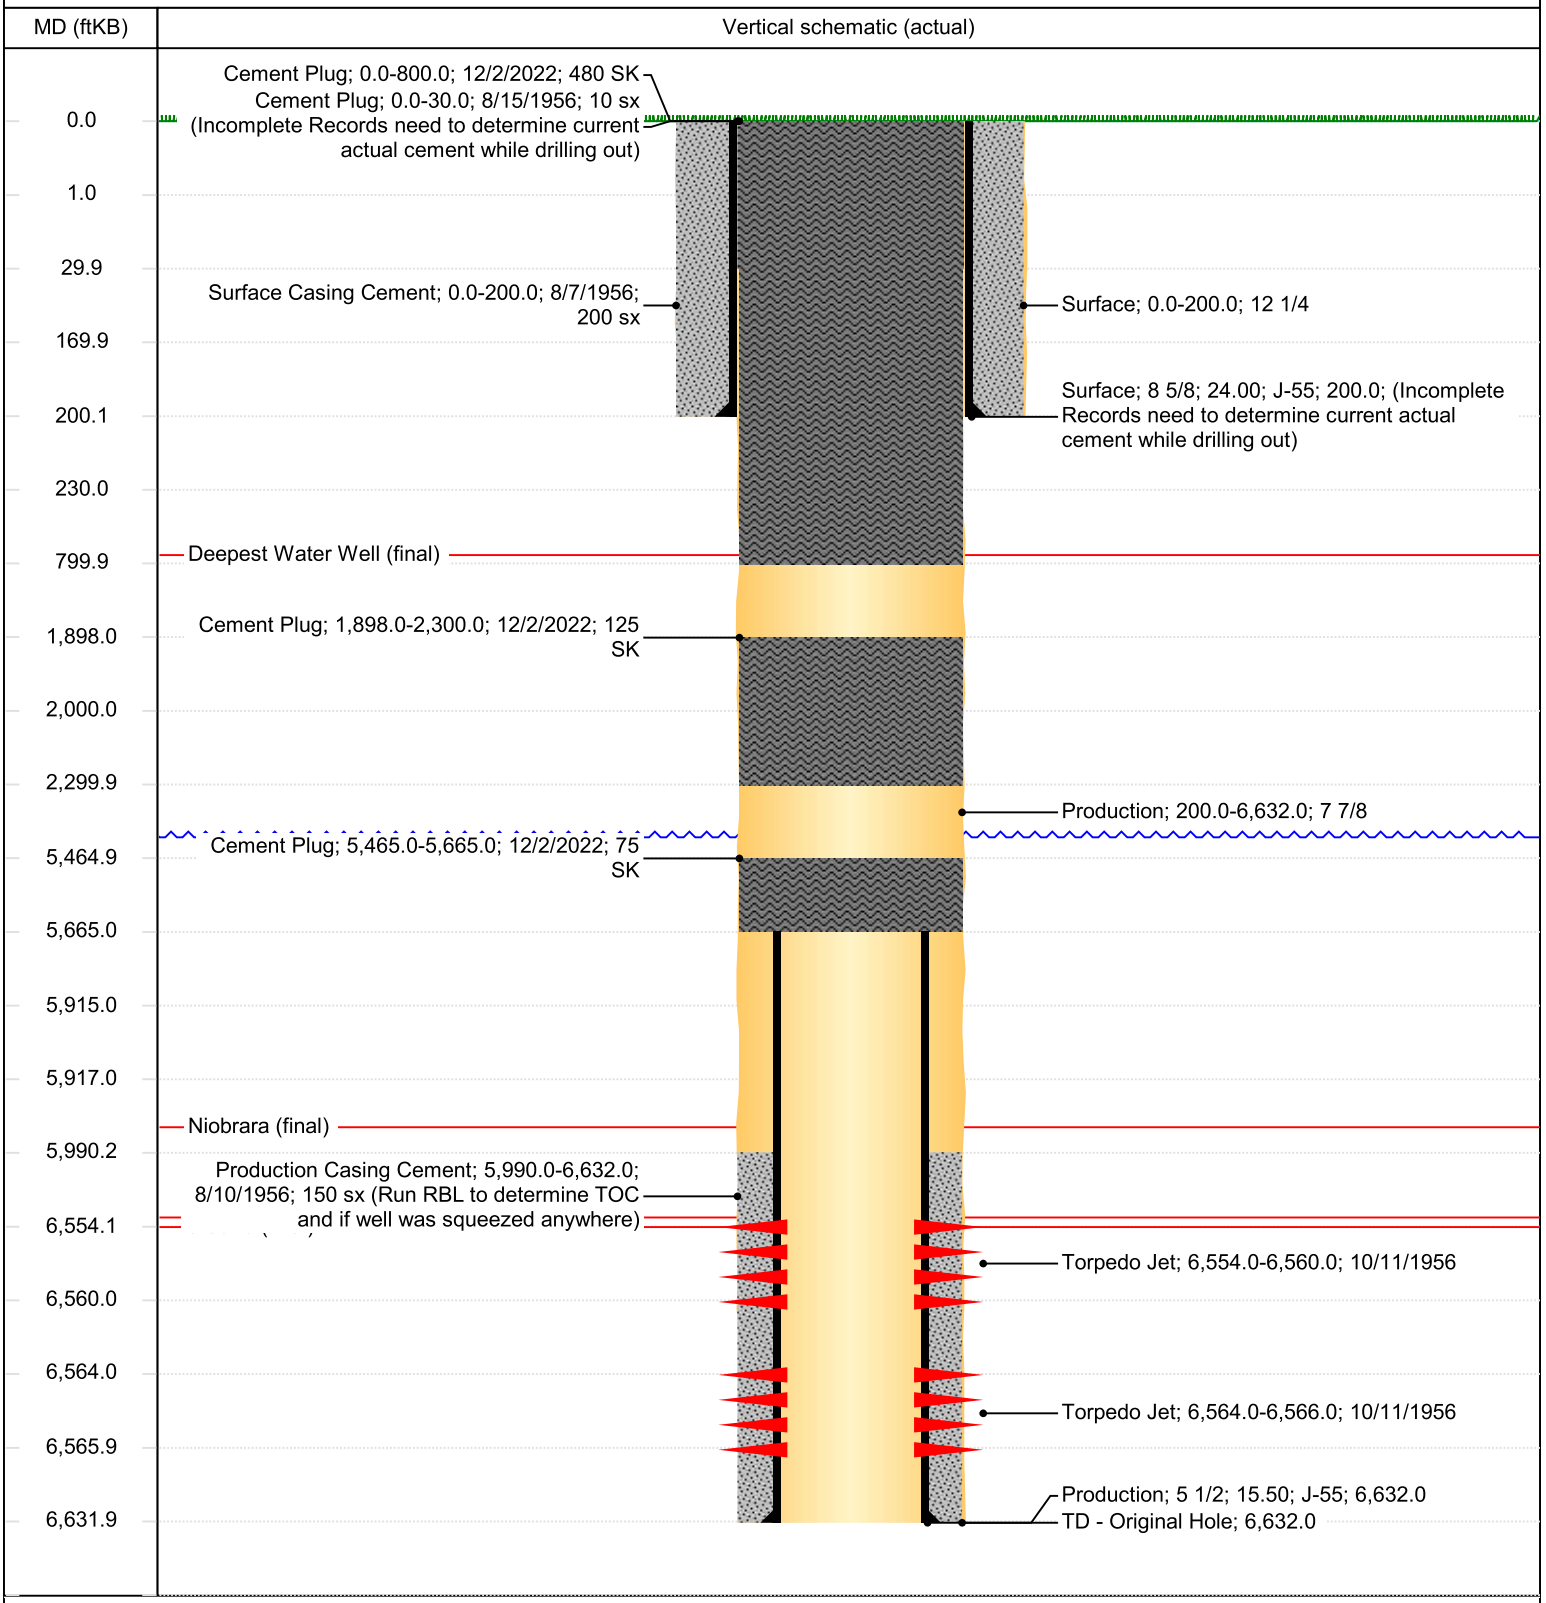
Original Hole, 1/6/2023 3:53:47 PM