


**WELL NAME:** Mickey 8  
**FIELD:** Wattenberg  
**SHL:** qtr-qtr SWNE Section 5 Township 6N Range 67W  
**BHL:** qtr-qtr Lot 1 Section 3 Township 6N Range 67W  
**COUNTY:** Weld STATE: CO API: 05-123-43856  
**OPERATOR:** Extraction Oil & Gas Inc  
**FORMATION:** Niobrara

not to scale  
**GROUND LEVEL:** 4880'  
**KELLY BUSHING:** 4905'  
**SPUD DATE:** 12/2/2016  
**TD DATE:** 1/27/2017

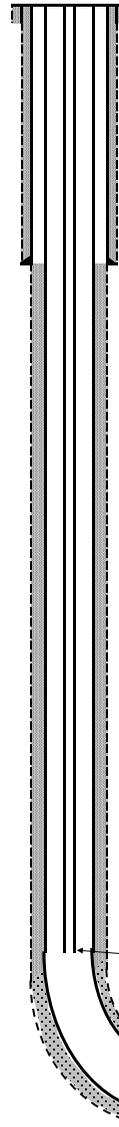

**CONDUCTOR CASING**  
 SIZE: 16"  
 WEIGHT: 42#  
 HOLE SIZE: 24"  
 CSG DEPTH: 80'

**SURFACE CASING**  
 SIZE: 9 5/8"  
 WEIGHT: 36#  
 HOLE SIZE: 12 1/4"  
 HOLE DEPTH: 1555'  
 CSG DEPTH: 1555'  
 CEMENT: 550 sx  
 TOC: Surface

**PRODUCTION CASING**  
 SIZE: 5 1/2"  
 WEIGHT: 20#  
 HOLE SIZE: 7 7/8"  
 TOTAL DEPTH TVD: 6992'  
 TOTAL DEPTH MD: 17410'  
 CSG DEPTH: 17390'  
 CEMENT: 2200 sx  
 TOC: 1533'

**PRODUCTION TUBING**  
 SIZE: 2 3/8"  
 WEIGHT: 4.7#  
 DEPTH: 7235'  
 PACKER DEPTH: --

**FORMATION TOPS & PERFORATIONS**  
 NIOBRARA MD 7049'  
 PERFORATIONS 7406'-17338'

**FRAC DATA**  
 1,226 BBLs ACID  
 515,233 BBLs FRESH WATER  
 516,459 BBLs TOTAL FLUID  
 33,200,490 # 40/70 PROPPANT  
 83 # TOTAL STAGES

EOT @ 7235'

Production Csg @ 17390'  
 MD TD 17410'