




CALCULATION SHEET
CHEVRON OIL COMPANY

Date 9/19/72

Prepared by JPH Page No. of

Title Andre #1 Loc: SE 1/4, SE 1/4 Sec 22 T8N, R66W, Weld Co. Colo.

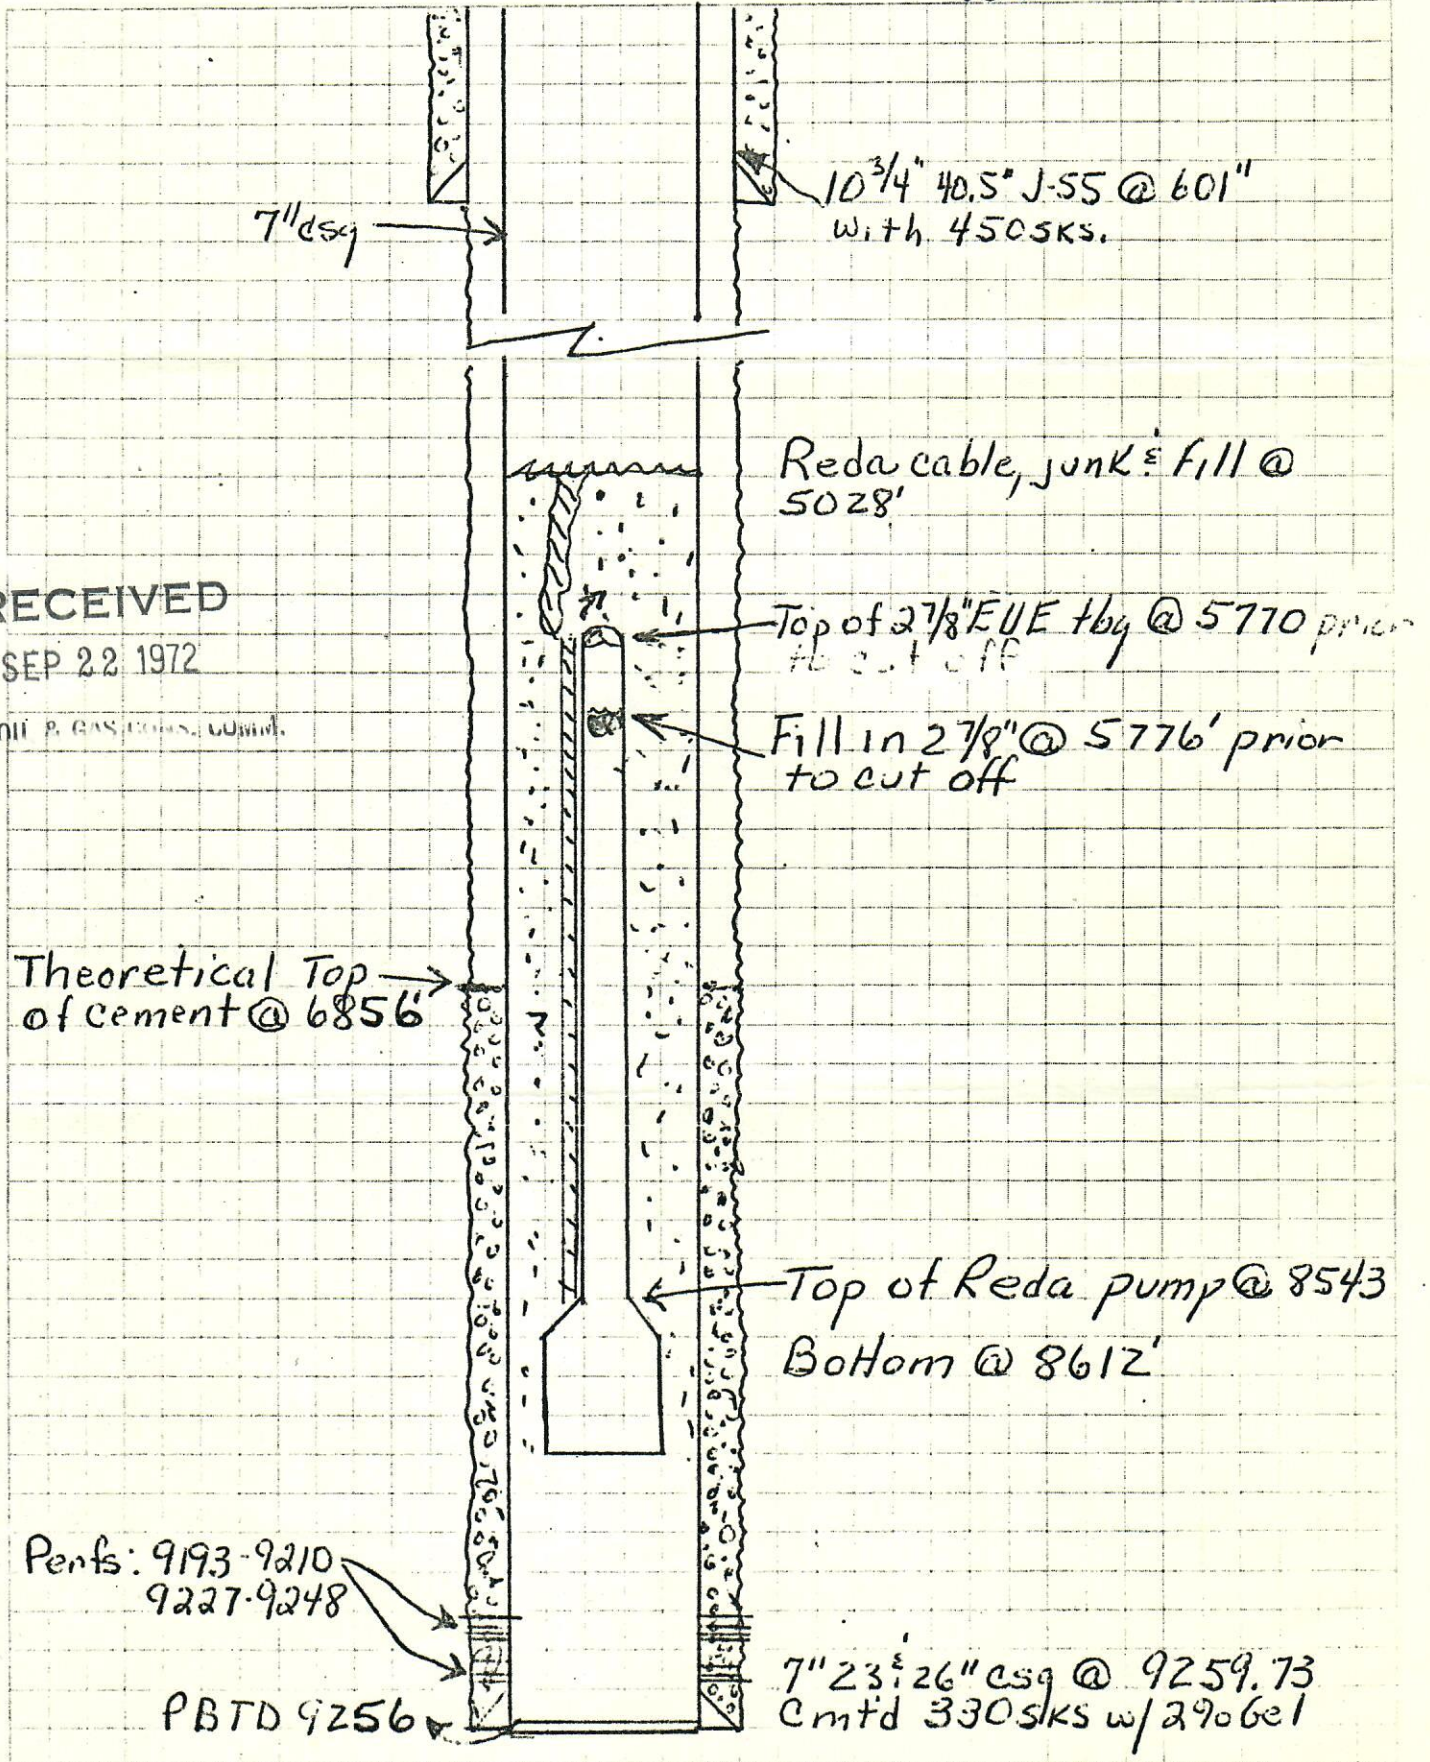

RECEIVED
SEP 22 1972

