




00212903

OIL AND GAS CONSERVATION COMMISSION OF THE STATE OF COLORADO

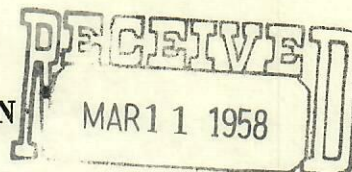

NOTICE OF INTENTION TO DRILL

OIL AND GAS
CONSERVATION COMMISSION

INSTRUCTIONS:

A notice of intention to drill a well shall be filed in duplicate on all Federal and Patented lands, and in triplicate on all State lands. Do not begin operations until approved copy has been received. It is mandatory that the proposed location comply with all rules and regulations of the Commission. Locate well on section grid in proper location, and indicate extent of lease. Unless operations are commenced within 180 days after the date of approval hereof, this approval to drill will become null and void.

Name of Operator Cabeen Exploration Corporation Phone No. AMherst 6-1635
Address 719 Farmers Union Building City Denver State Colorado


How is liability secured: Well Bond (Attached) ☐; Blanket Bond ☒; Waiver ☐
(Check one)

Lease Name Bradley

Well No. #5

Field Name Tow Creek Wildcat ☐

County Routt

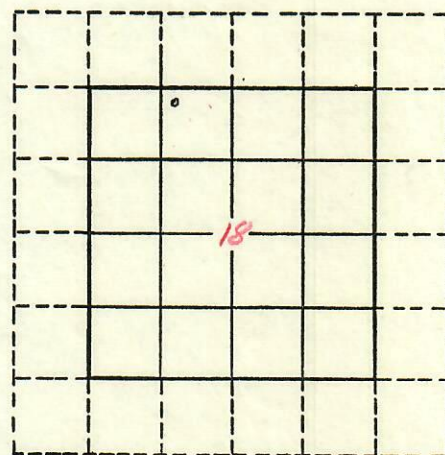

Location CNW NE NW Section 18 Township 6N Range 86W Meridian 6th
(quarter quarter)
330 feet from N Section line and 1650 feet from W Section Line
N or S E or W

The well is located on: Patented land ☒ State land ☐ Federal land ☐

The well is located within a spaced area: Yes ☐ No ☒

Distance from proposed location to nearest property or lease line 330 feet.

Distance from proposed location to nearest drilling unit line 330 feet.

Objectives: Niobrara Depth ; Depth
Formation Estimate Formation Estimate

Proposed length of surface casing 100 feet.

REMARKS:

Will drill with cable tools to test the Niobrara fracture shale producing zone at approximately 3000'. Will set production casing on top of pay, if test proves commercial, then rat hole into pay section. Caving and water bearing formations will be controlled using intermediate casing strings.

Agent	<u>CK</u>
Bond	<u>waived</u>
Spot	
600 ft.	<u>shale</u>
1200 ft.	
Wells	
Oil	
Gas	
Status	

I/We hereby swear (or affirm) that the statements herein made are a full and correct report.

APPROVED:

Date MAR 11 1958

Company Cabeen Exploration Corp. Date 3-7-58

Address 719 Farmers Union Bldg. Phone No. AM 6-1635

By [Signature] Title Landman

Director

Signature