Proposed P&A WBD

Well Name: BOOTH C35-01

Land, Original Hole, 2/1/2023 3:07:50 PM
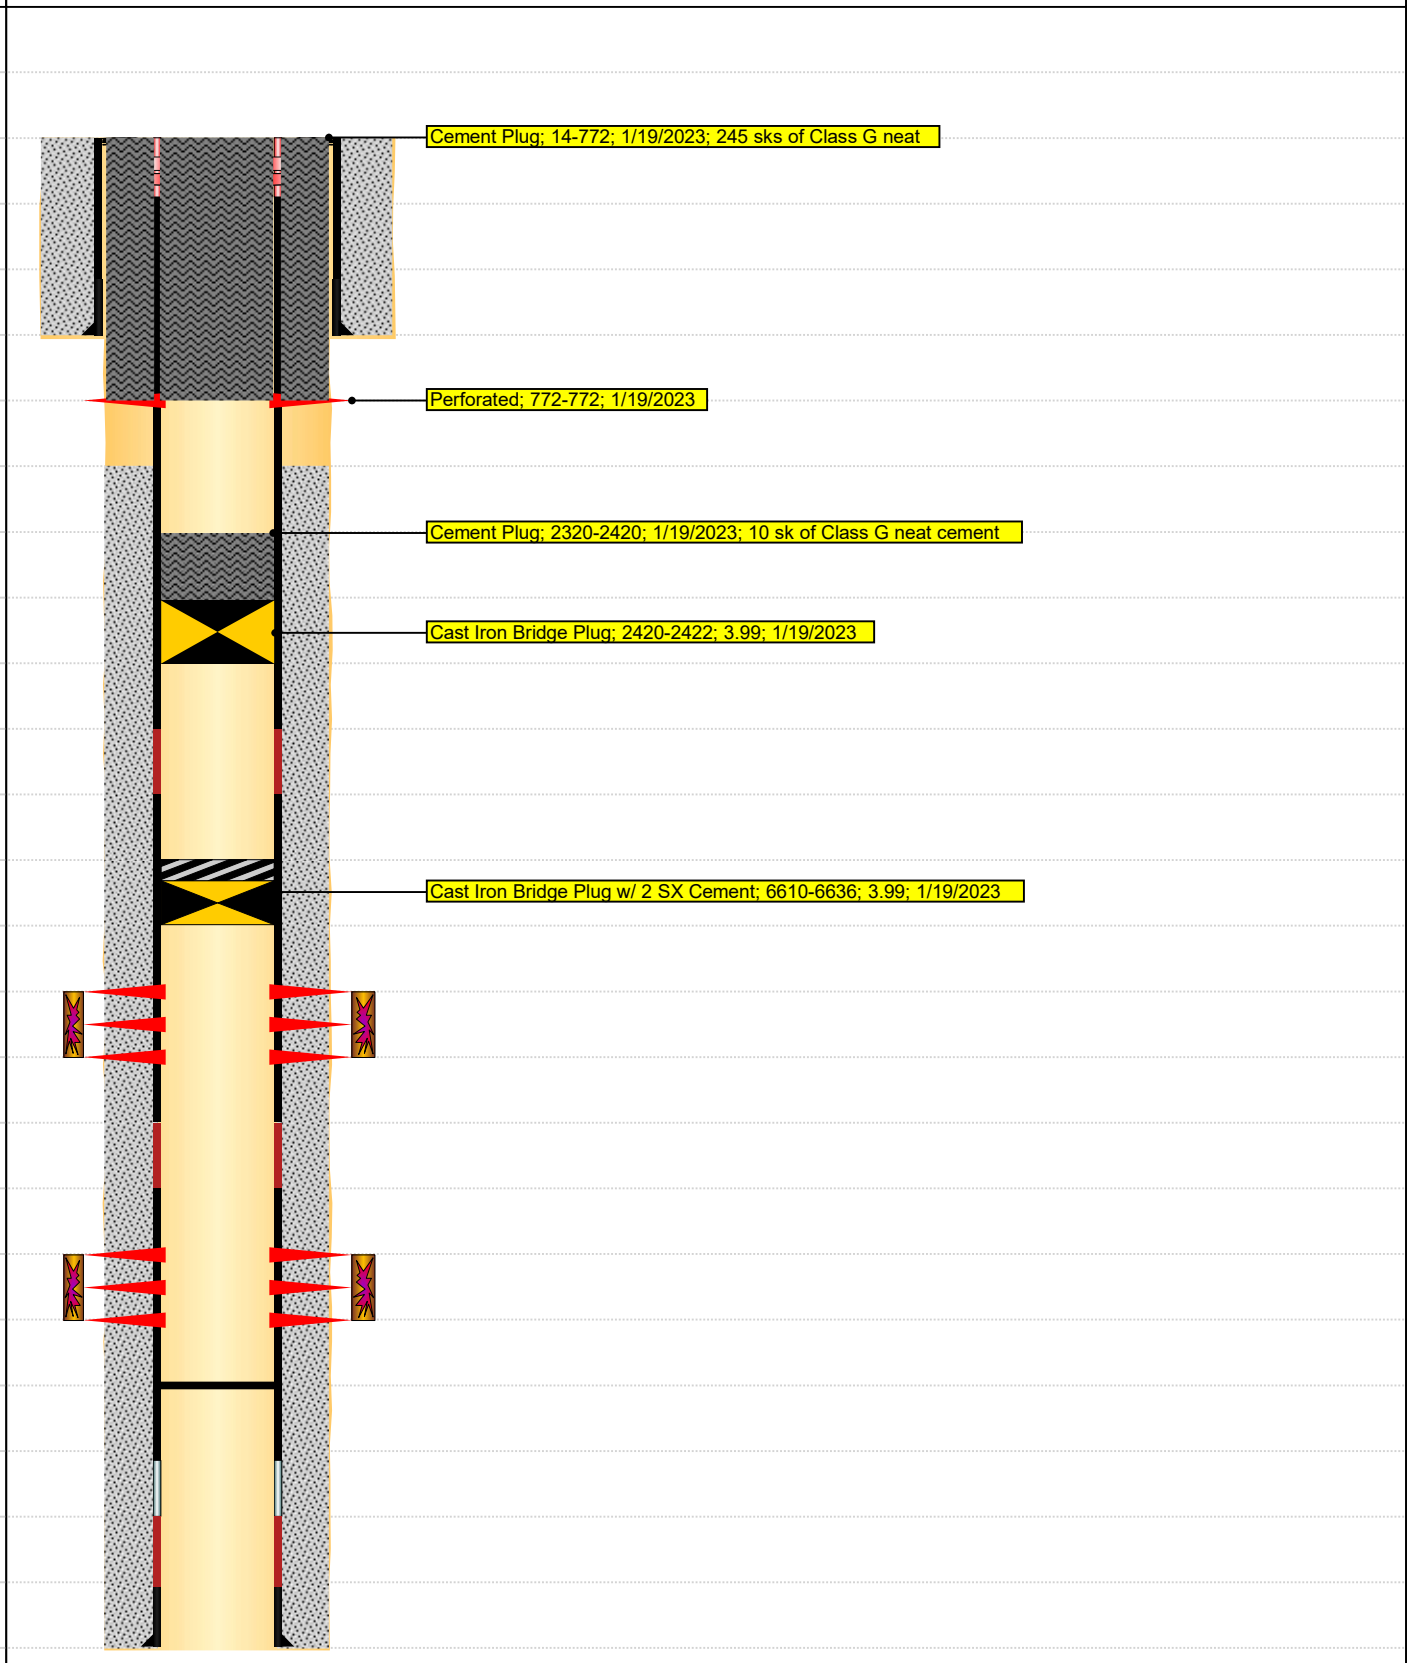
MD (ftKB)	Vertical schematic (proposed)