


TO: FREMONT PET. CO., DENVER, COLORADO
LEASE LOCATION SEC. 9, T. 19S., R. 45W., 6th P.M.
WELL NAME HARRISON # 2 LOCATION CEN. NE¹/₄ NE¹/₄
COUNTY KIOWA STATE COLORADO



00573320

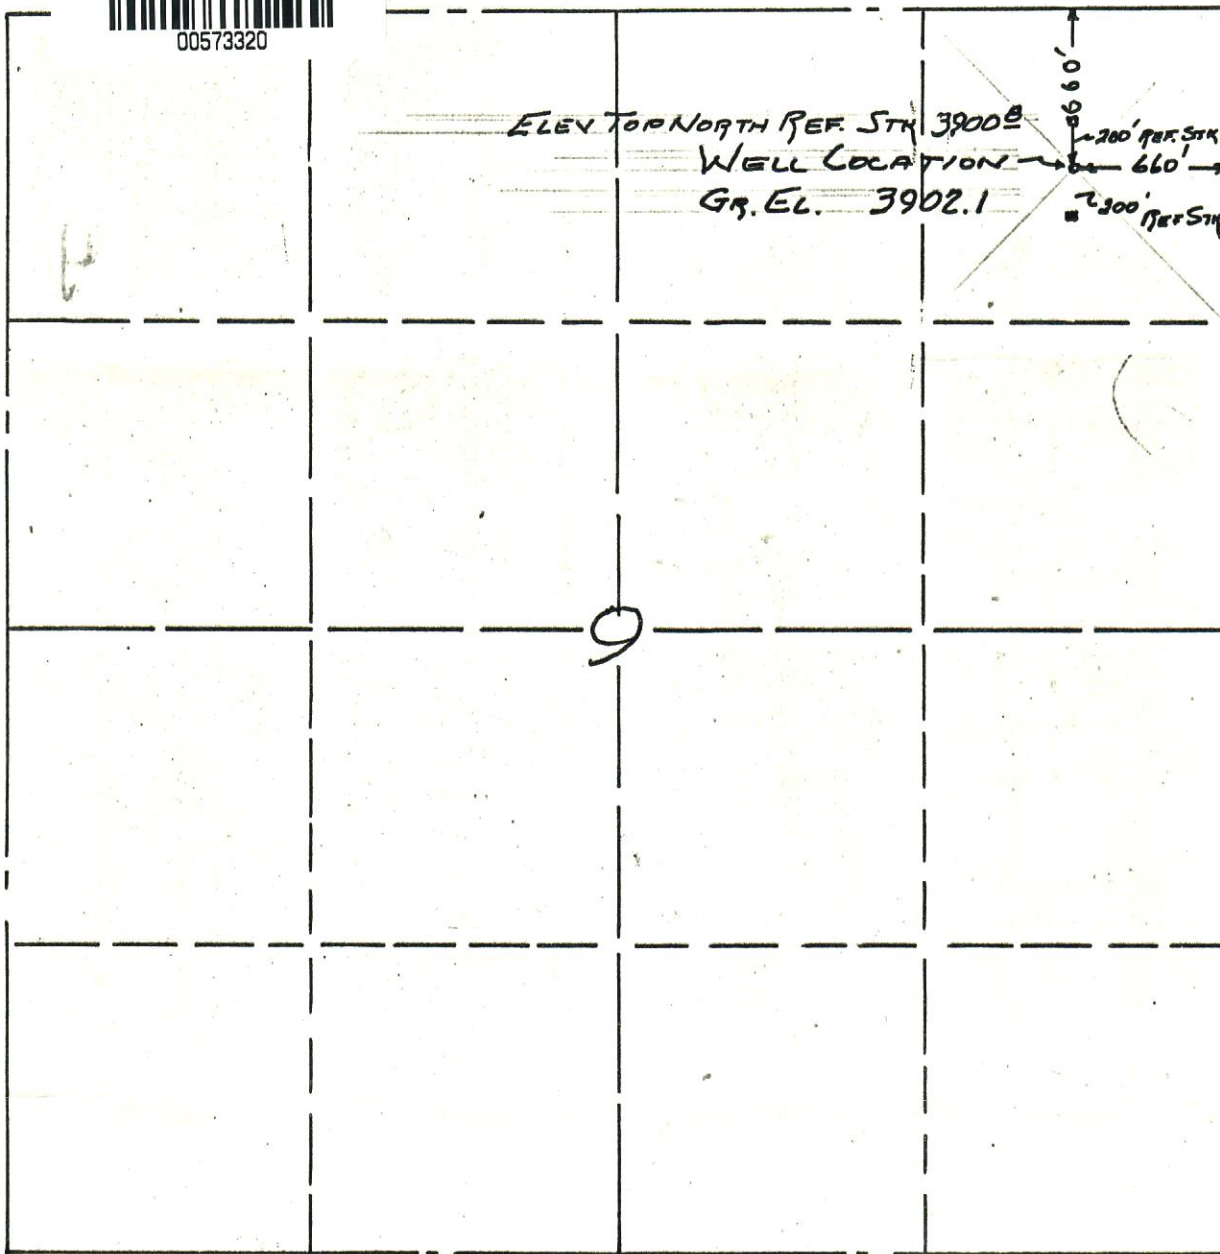


I, HEREBY CERTIFY THAT THE WELL LOCATION SHOWN ON THE ABOVE PLAT WAS STAKED AND MEASURED AS SHOWN ON THIS PLAT.

DATE 8 Aug 1966



Lamar G. Hiller
REGISTERED ENGINEER
LAMAR, COLO.

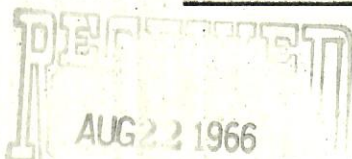

CONSERVATION COMMISSION