




RECEIVED

SEP - 5 1967

COLO. OIL & GAS CONS. COMM.

R. 45W

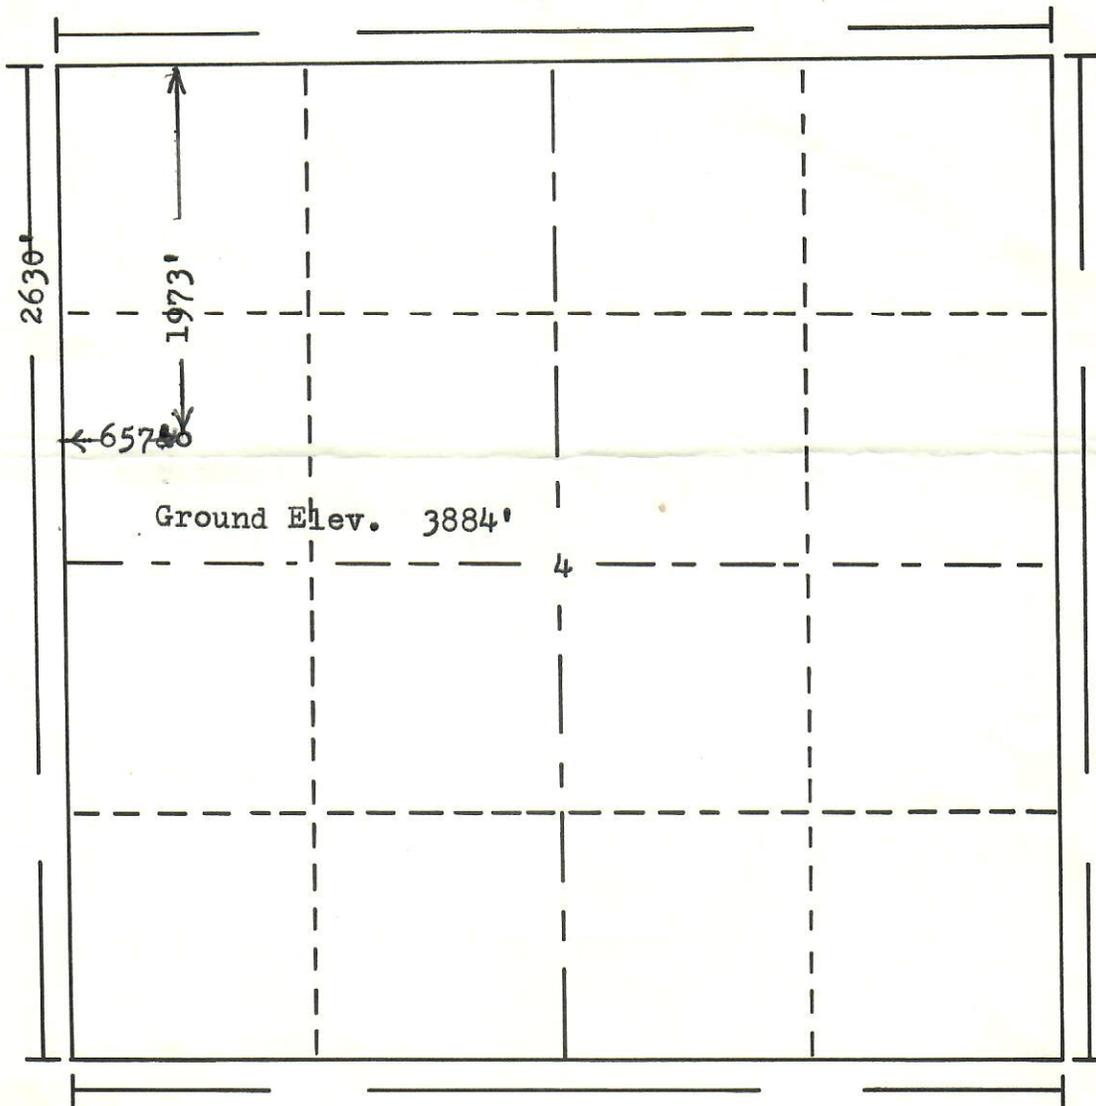

T. 19 S


Scale... 1" = 1000'

Powers Elevation Company, Inc. of Denver, Colorado
 has in accordance with a request from Mr. Minnick
 for Fremont Petroleum Co.

determined the location of No. A-1 Pyles
 to be CSW NW Section 4 Township 19S
 Range 45W of the 6th Principal Meridian
 Kiowa County, Colorado

I hereby certify that this plat is an
 accurate representation of a correct
 survey showing the location of

Date: 8-15-67

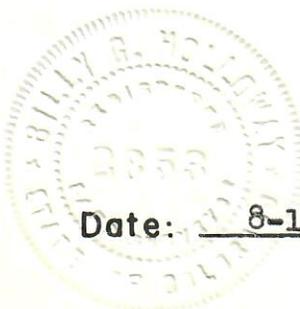

Billy G. Hollaway
 Licensed Land Surveyor No. 2853
 State of Colorado