



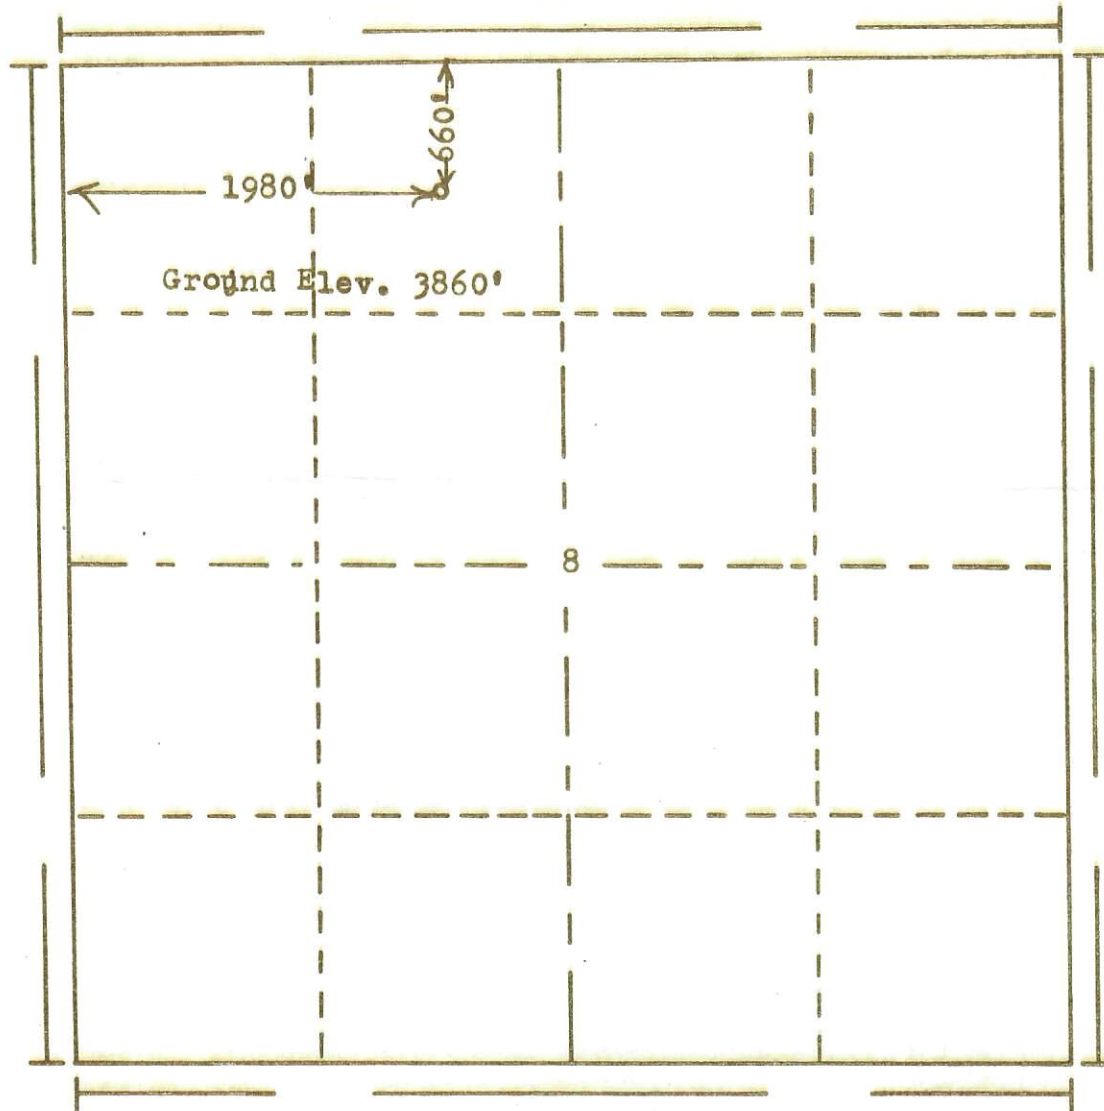
00572877

RECEIVED

JUL - 8 1971

COLD, OIL & GAS CONS. COMM.

R. 45W

T.
19
S

Scale... 1" = 1000'

Powers Elevation Company, Inc. of Denver, Colorado
has in accordance with a request from Mr. Foster
for Inexco Oil Co.

determined the location of No. 1 KCGA
to be CNE NW Section 8 Township 19S
Range 45W of the 6th Principal Meridian
Kiowa County, Colorado

I hereby certify that this plat is an
accurate representation of a correct
survey showing the location of

Date: 5-27-71

B. D. Hall
Licensed Land Surveyor No. 2853
State of Colorado