




RECEIVED

NOV 1 1972

R. 45W



N

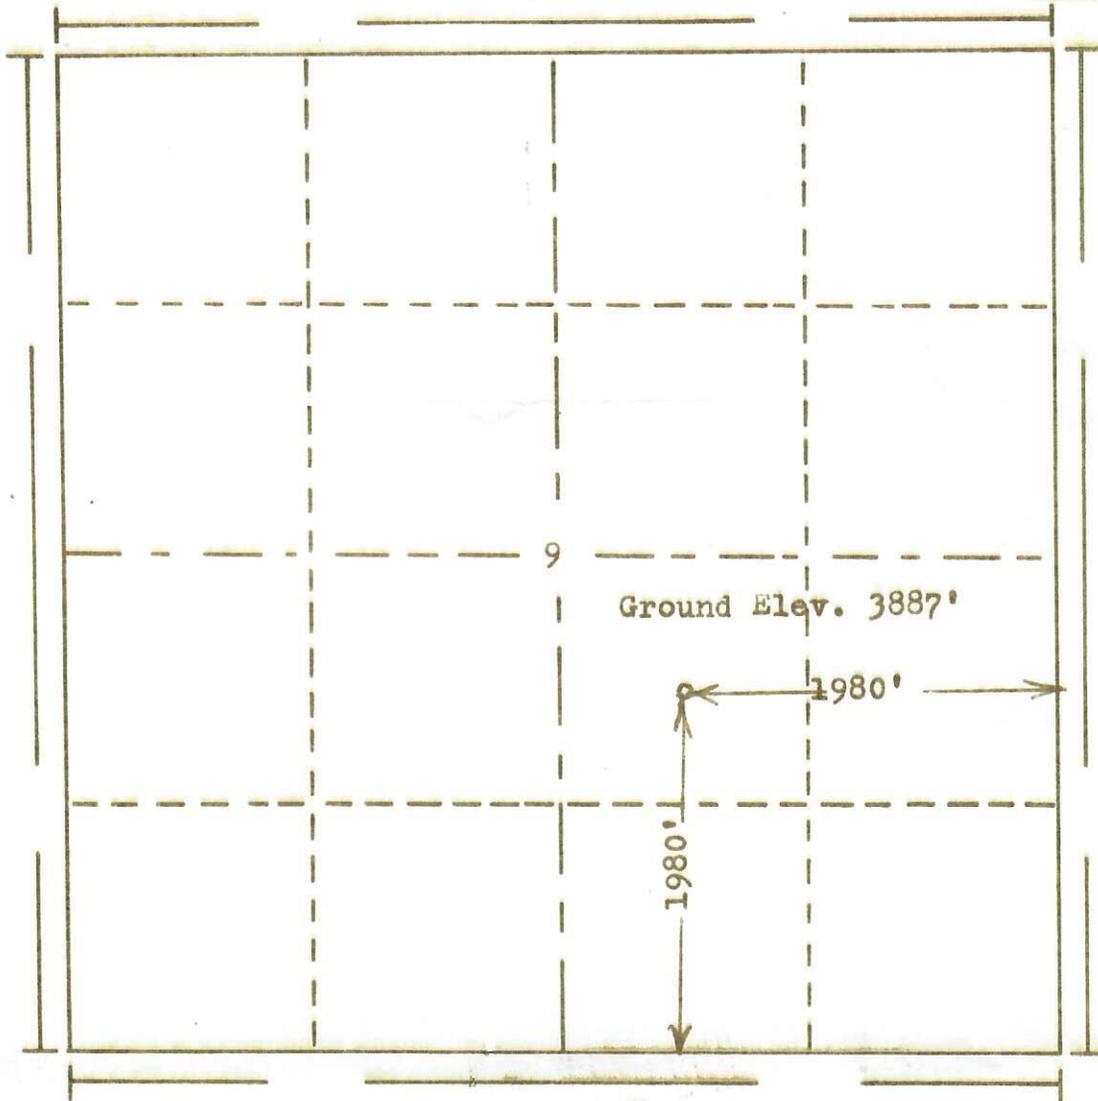

Scale... 1" = 1000'

Powers Elevation Company, Inc. of Denver, Colorado has in accordance with a request from Mr. Foster for Inexco Oil Co.

determined the location of No. 6 Harrison to be CNW 3E Section 9 Township 19S Range 45W of the 6th Principal Meridian Kiowa County, Colorado

I hereby certify that this plat is an accurate representation of a correct survey showing the location of

Date: 10-16-72

B. J. Hall
Licensed Land Surveyor No. 2853
State of Colorado