

OPERATOR: CLEARY PET. INC. ADDRESS: 310 KERMAC BUDG.




00554751

LOCATION: SECTION 32, T. 19 S., R. 45 W., 6<sup>th</sup> P.M.

WELL NAME: \_\_\_\_\_ COUNTY: KIOWA

LOCATION: CEN NW 1/4 NW 1/4 STATE: COLORADO

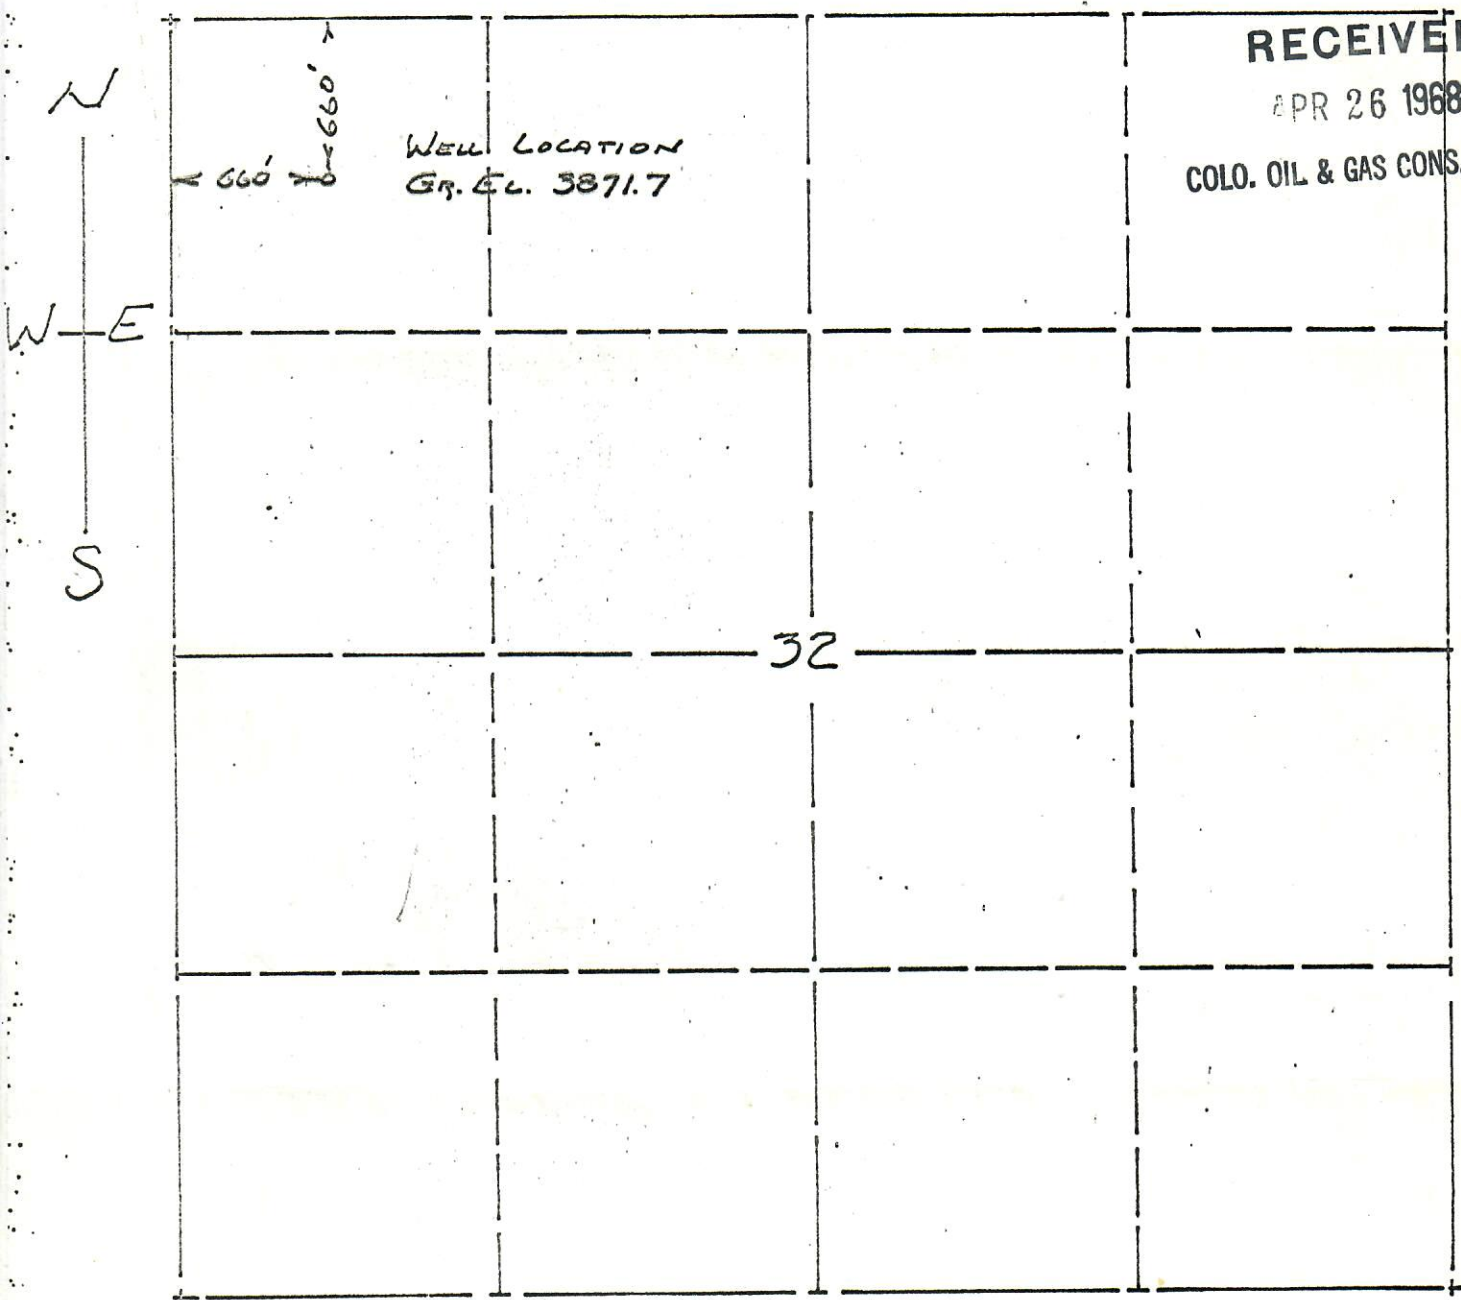

RECEIVED

APR 26 1968

COLO. OIL & GAS CONS. COMM.

I HEREBY CERTIFY THAT THE WELL LOCATION  
SHOWN ON THE ABOVE PLAT WAS STAKED AND  
MEASURED AS SHOWN ON THIS PLAT.

DATE: 19 APRIL 1968

Shake L. Hillyer  
REGISTERED ENGINEER  
LAMAR COLORADO

