


City and County of Denver and Adams County, CO

BOX ELDER K 3
SS01

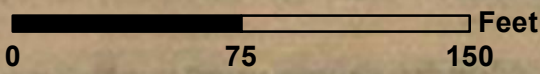

Legend

- Soil Sample
- ⊙ Plugged & Abandoned Well



Mapping by: K. O'Brien, 2/6/2023
Coordinate System:
NAD 1983 UTM Zone 13 N

Location: NENW Sec 6 T2S R65W 6th PM

Figure 1
Box Elder K #3
Project Map
City & County of Denver