


To: FREMONT PET. CO., DENVER, COLO.  
LEASE LOCATION SEC 10, T.19S, R.45W, 6TH P.M.  
WELL NAME ~~U.S. No 1-10~~ LOCATION CEN SW 1/4 NE 1/4  
COUNTY KIOWA STATE NEBRASKA

N  
W E  
S

✓ NO. 1 USA-BUTLER




MAY 8 - 1967  
COLO. OIL & GAS CONS. COMM.

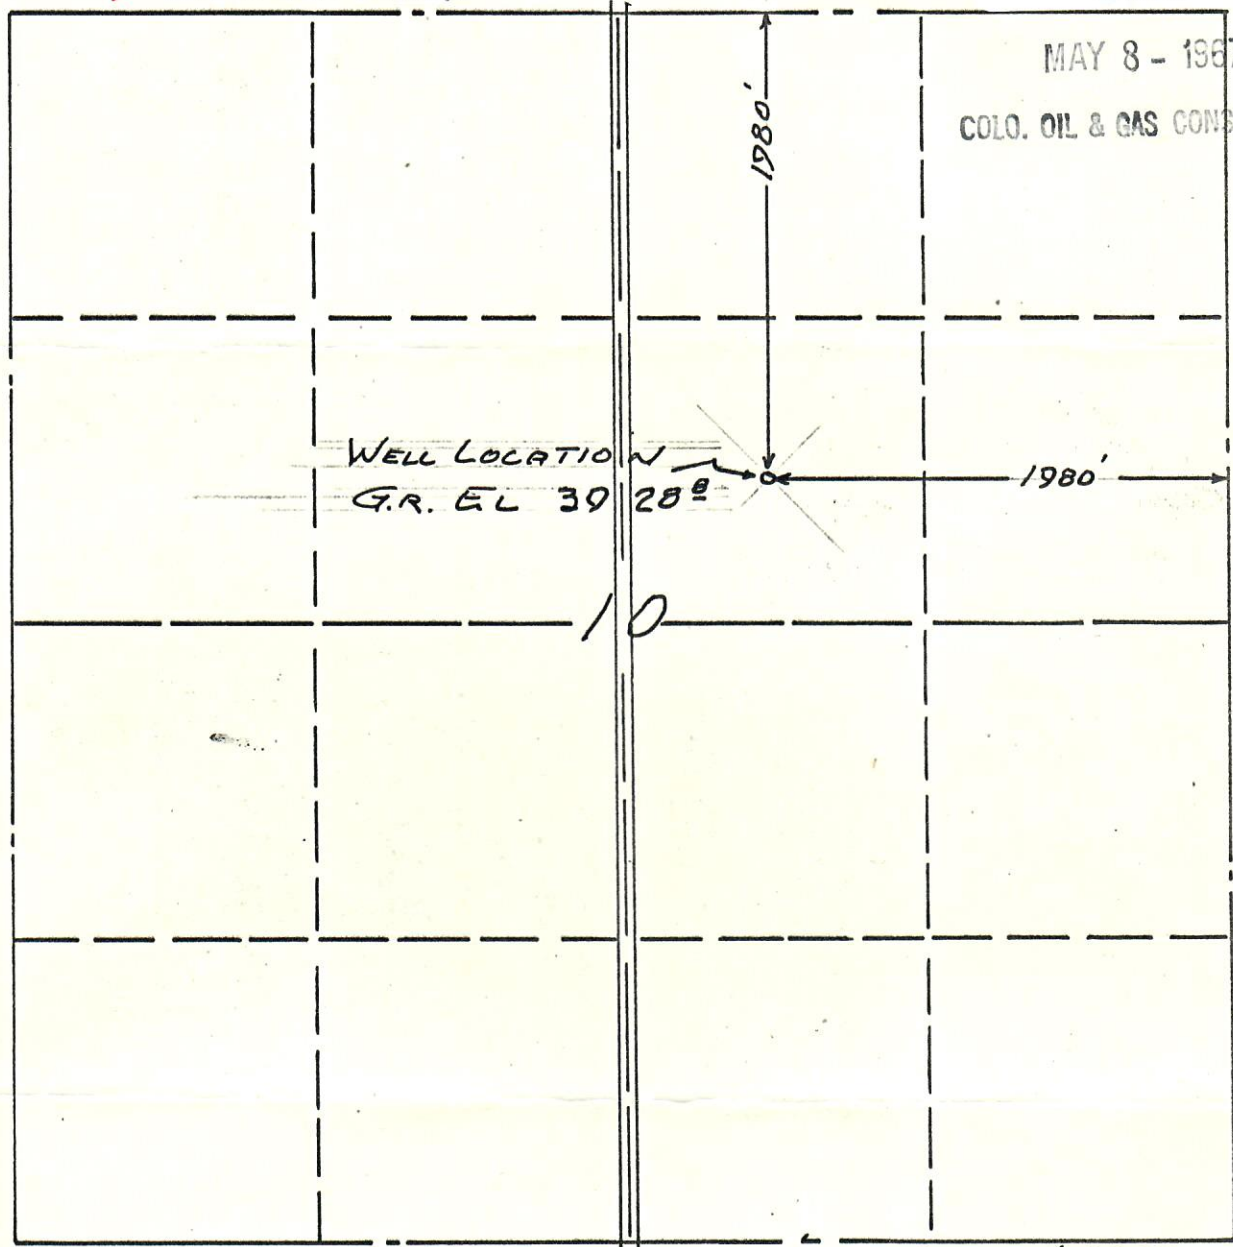

I, HEREBY CERTIFY THAT THE WELL LOCATION  
SHOWN ON THE ABOVE PLAT WAS STAKED AND  
MEASURED AS SHOWN ON THIS PLAT.

DATE 3 MAY 1967

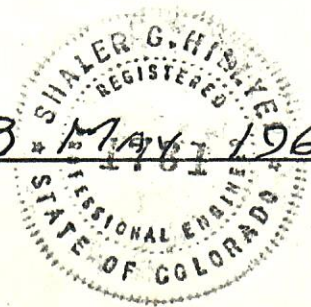

Shaler G. Hilgen  
REGISTERED ENGINEER  
LAMAR, COLO.