




00572250

AUG 16 1972

R. 45W

COLO. OIL & GAS COMS. COMM.

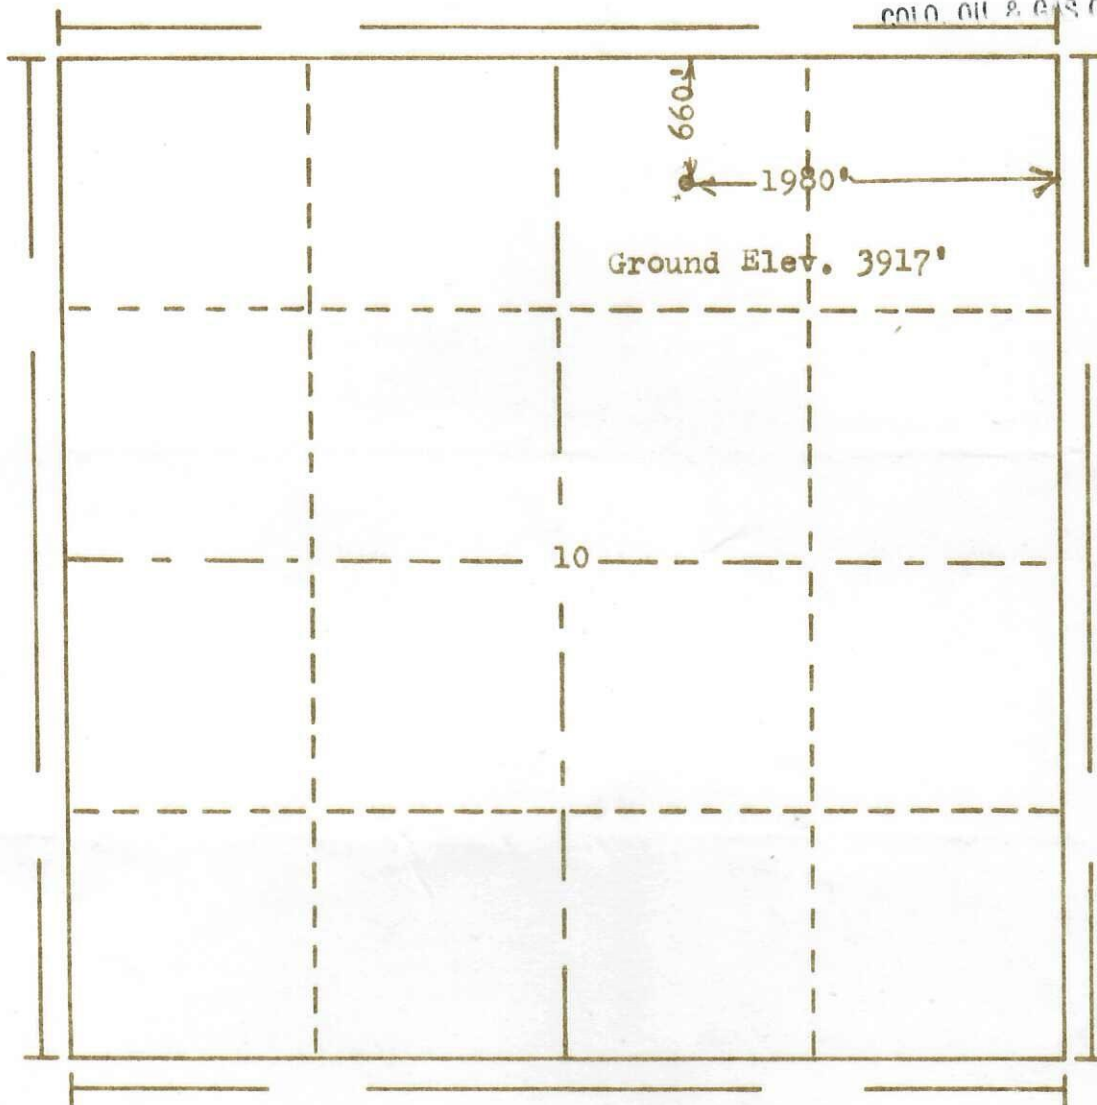

Scale... 1" = 1000'

Powers Elevation Company, Inc. of Denver, Colorado
has in accordance with a request from Mr. Foster
for Inexco Oil Co.

determined the location of No. 2 USA-Butler
to be CNW NE Section 10 Township 19S
Range 45W of the 6th Principal Meridian
Kiowa County, Colorado

I hereby certify that this plat is an
accurate representation of a correct
survey showing the location of

Date: 7-22-72

Billy D. Hall
Licensed Land Surveyor No. 2853
State of Colorado