

To: FREMONT PET. CO., DENVER COLO.


LEASE LOCATION SEC. 9, T.19S., R.45W., 6th P.M.

WELL NAME HARRISON # 3 LOCATION SW $\frac{1}{4}$ NE $\frac{1}{4}$

COUNTY KIOWA STATE COLORADO



N
W
E
S

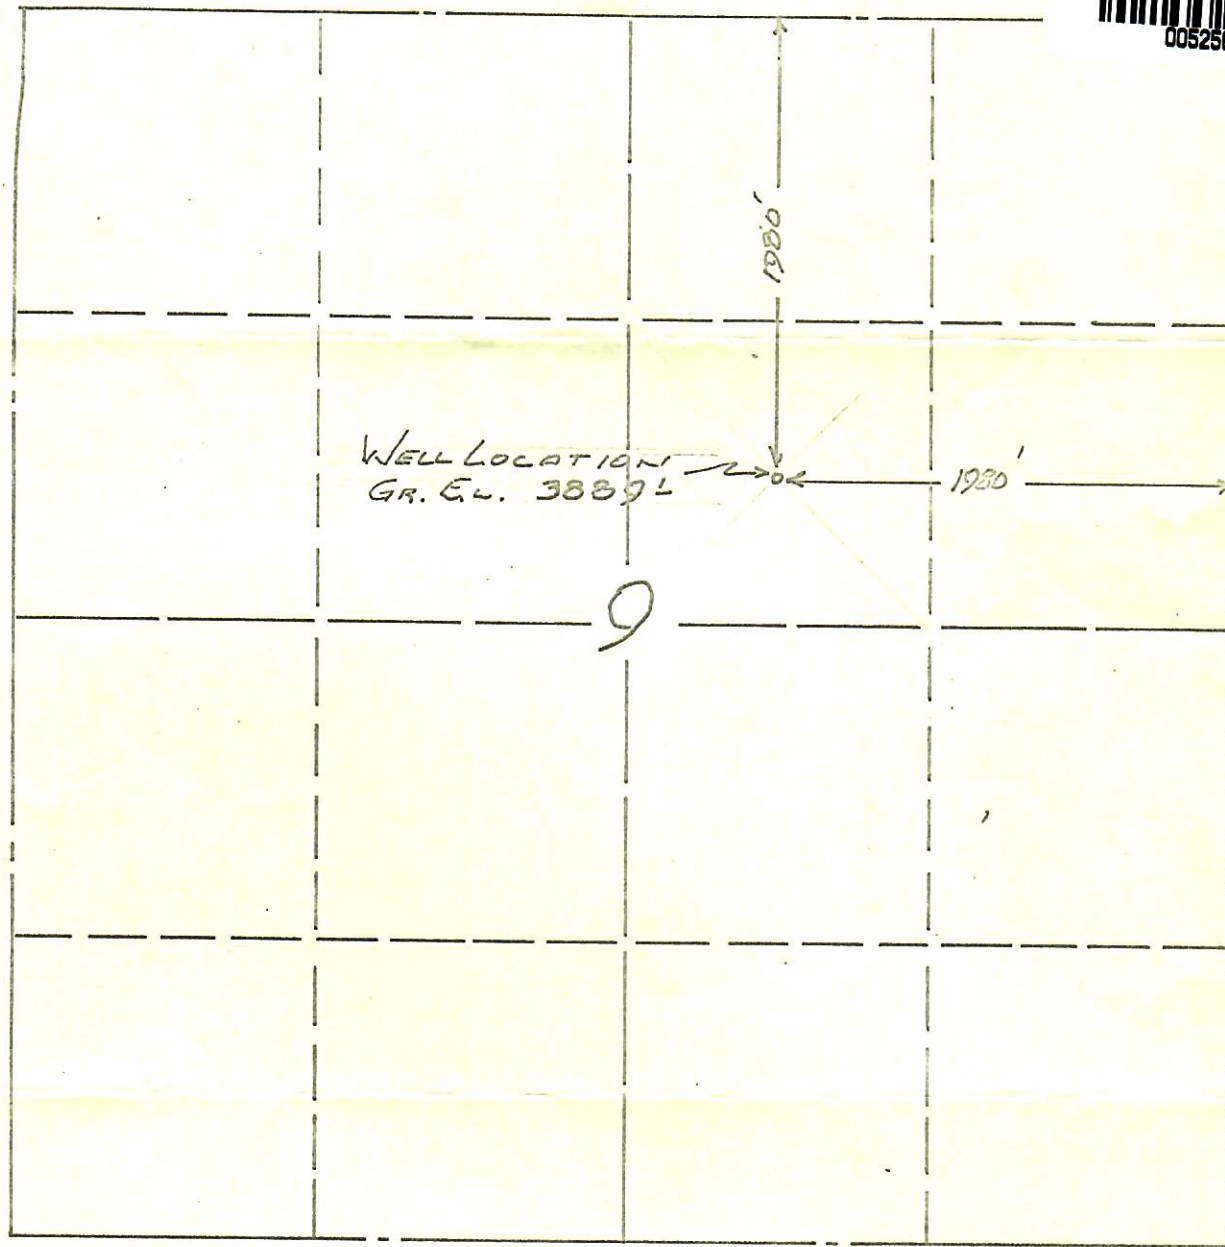

WELL LOCATION
GR. E.L. 3889 L

I, HEREBY CERTIFY THAT THE WELL LOCATION SHOWN ON THE ABOVE PLAT WAS SITED AND MEASURED AS SHOWN ON THIS PLAT.

RECEIVED

JUN 26 1967

COLO. OIL & GAS CONS. COMM.

DATE 21 JUNE 1967

Shawn D. Hilger
REGISTERED ENGINEER
LAMAR, COLO.