
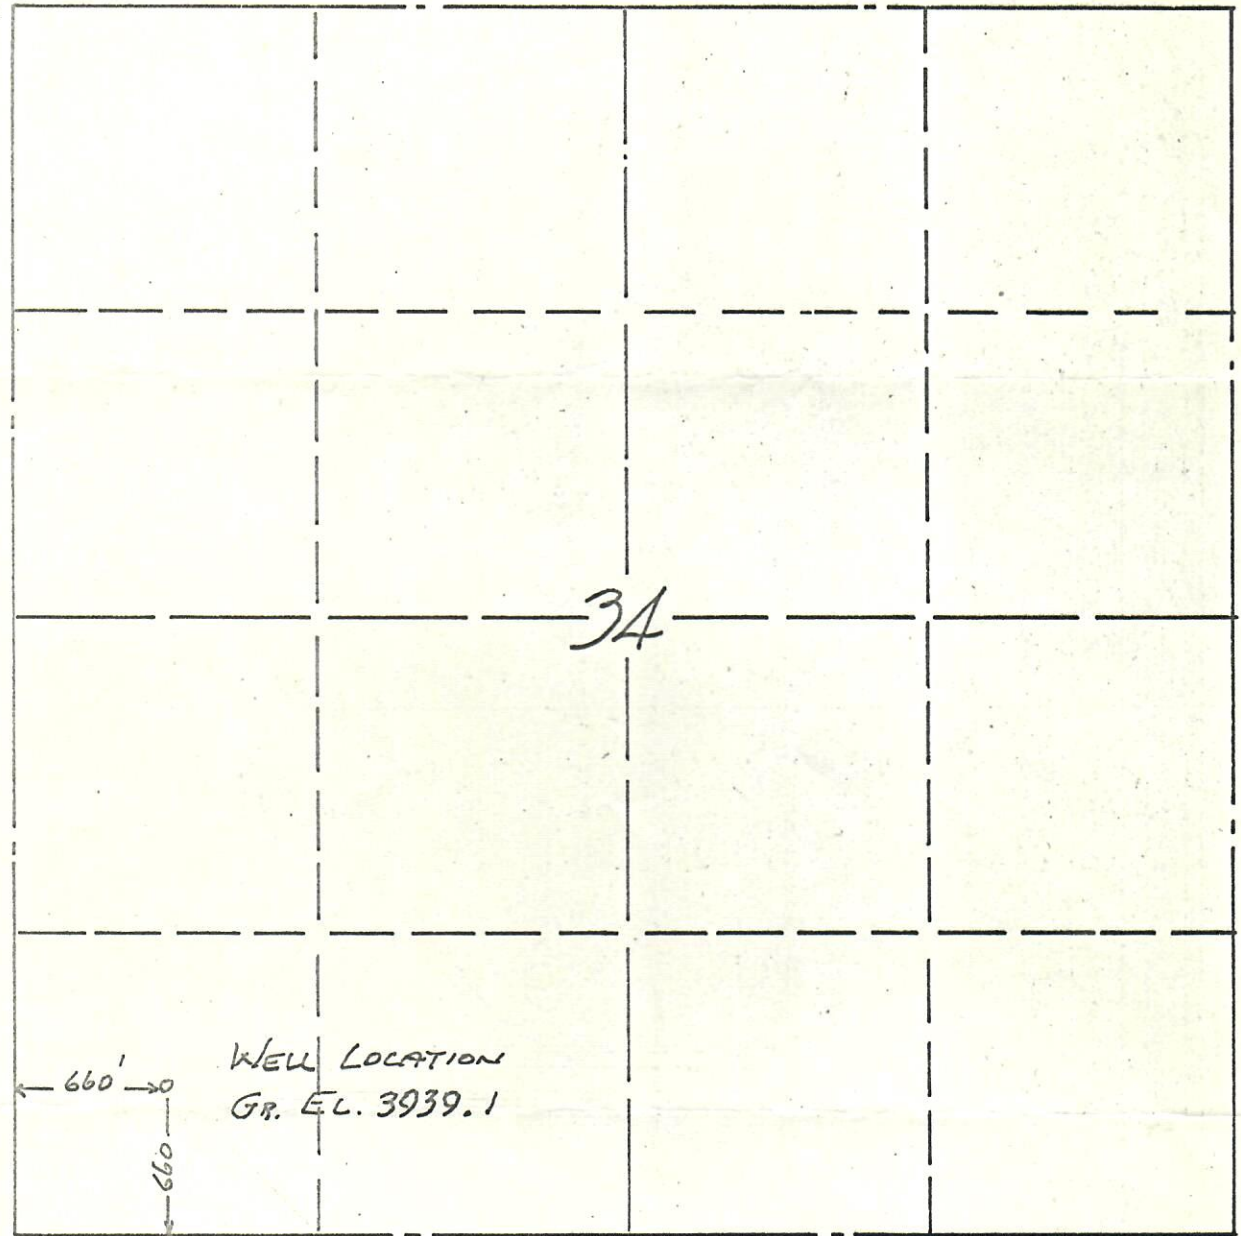


N
W
E
S

TO: FREMONT PET. CO., DENVER, COLO.
LEASE LOCATION, SEC. 34, T19S., R45W., 6TH P.M.
WE  (FARMS INC. 6-1) LOCATION GEN SW 1/4 SW 1/4
COUNTY, KIOWA STATE COLORADO



I, HEREBY CERTIFY THAT THE WELL LOCATION SHOWN ON THE ABOVE PLAT WAS STARED AND MEASURED AS SHOWN ON THIS PLAT

RECEIVED

APR 12 1967

COLO. OIL & GAS CONS. COMM.

DATE 6 APRIL 1967



Shawn D. Riley
REGISTERED ENGINEER
LAMAR, COLO.

69-129