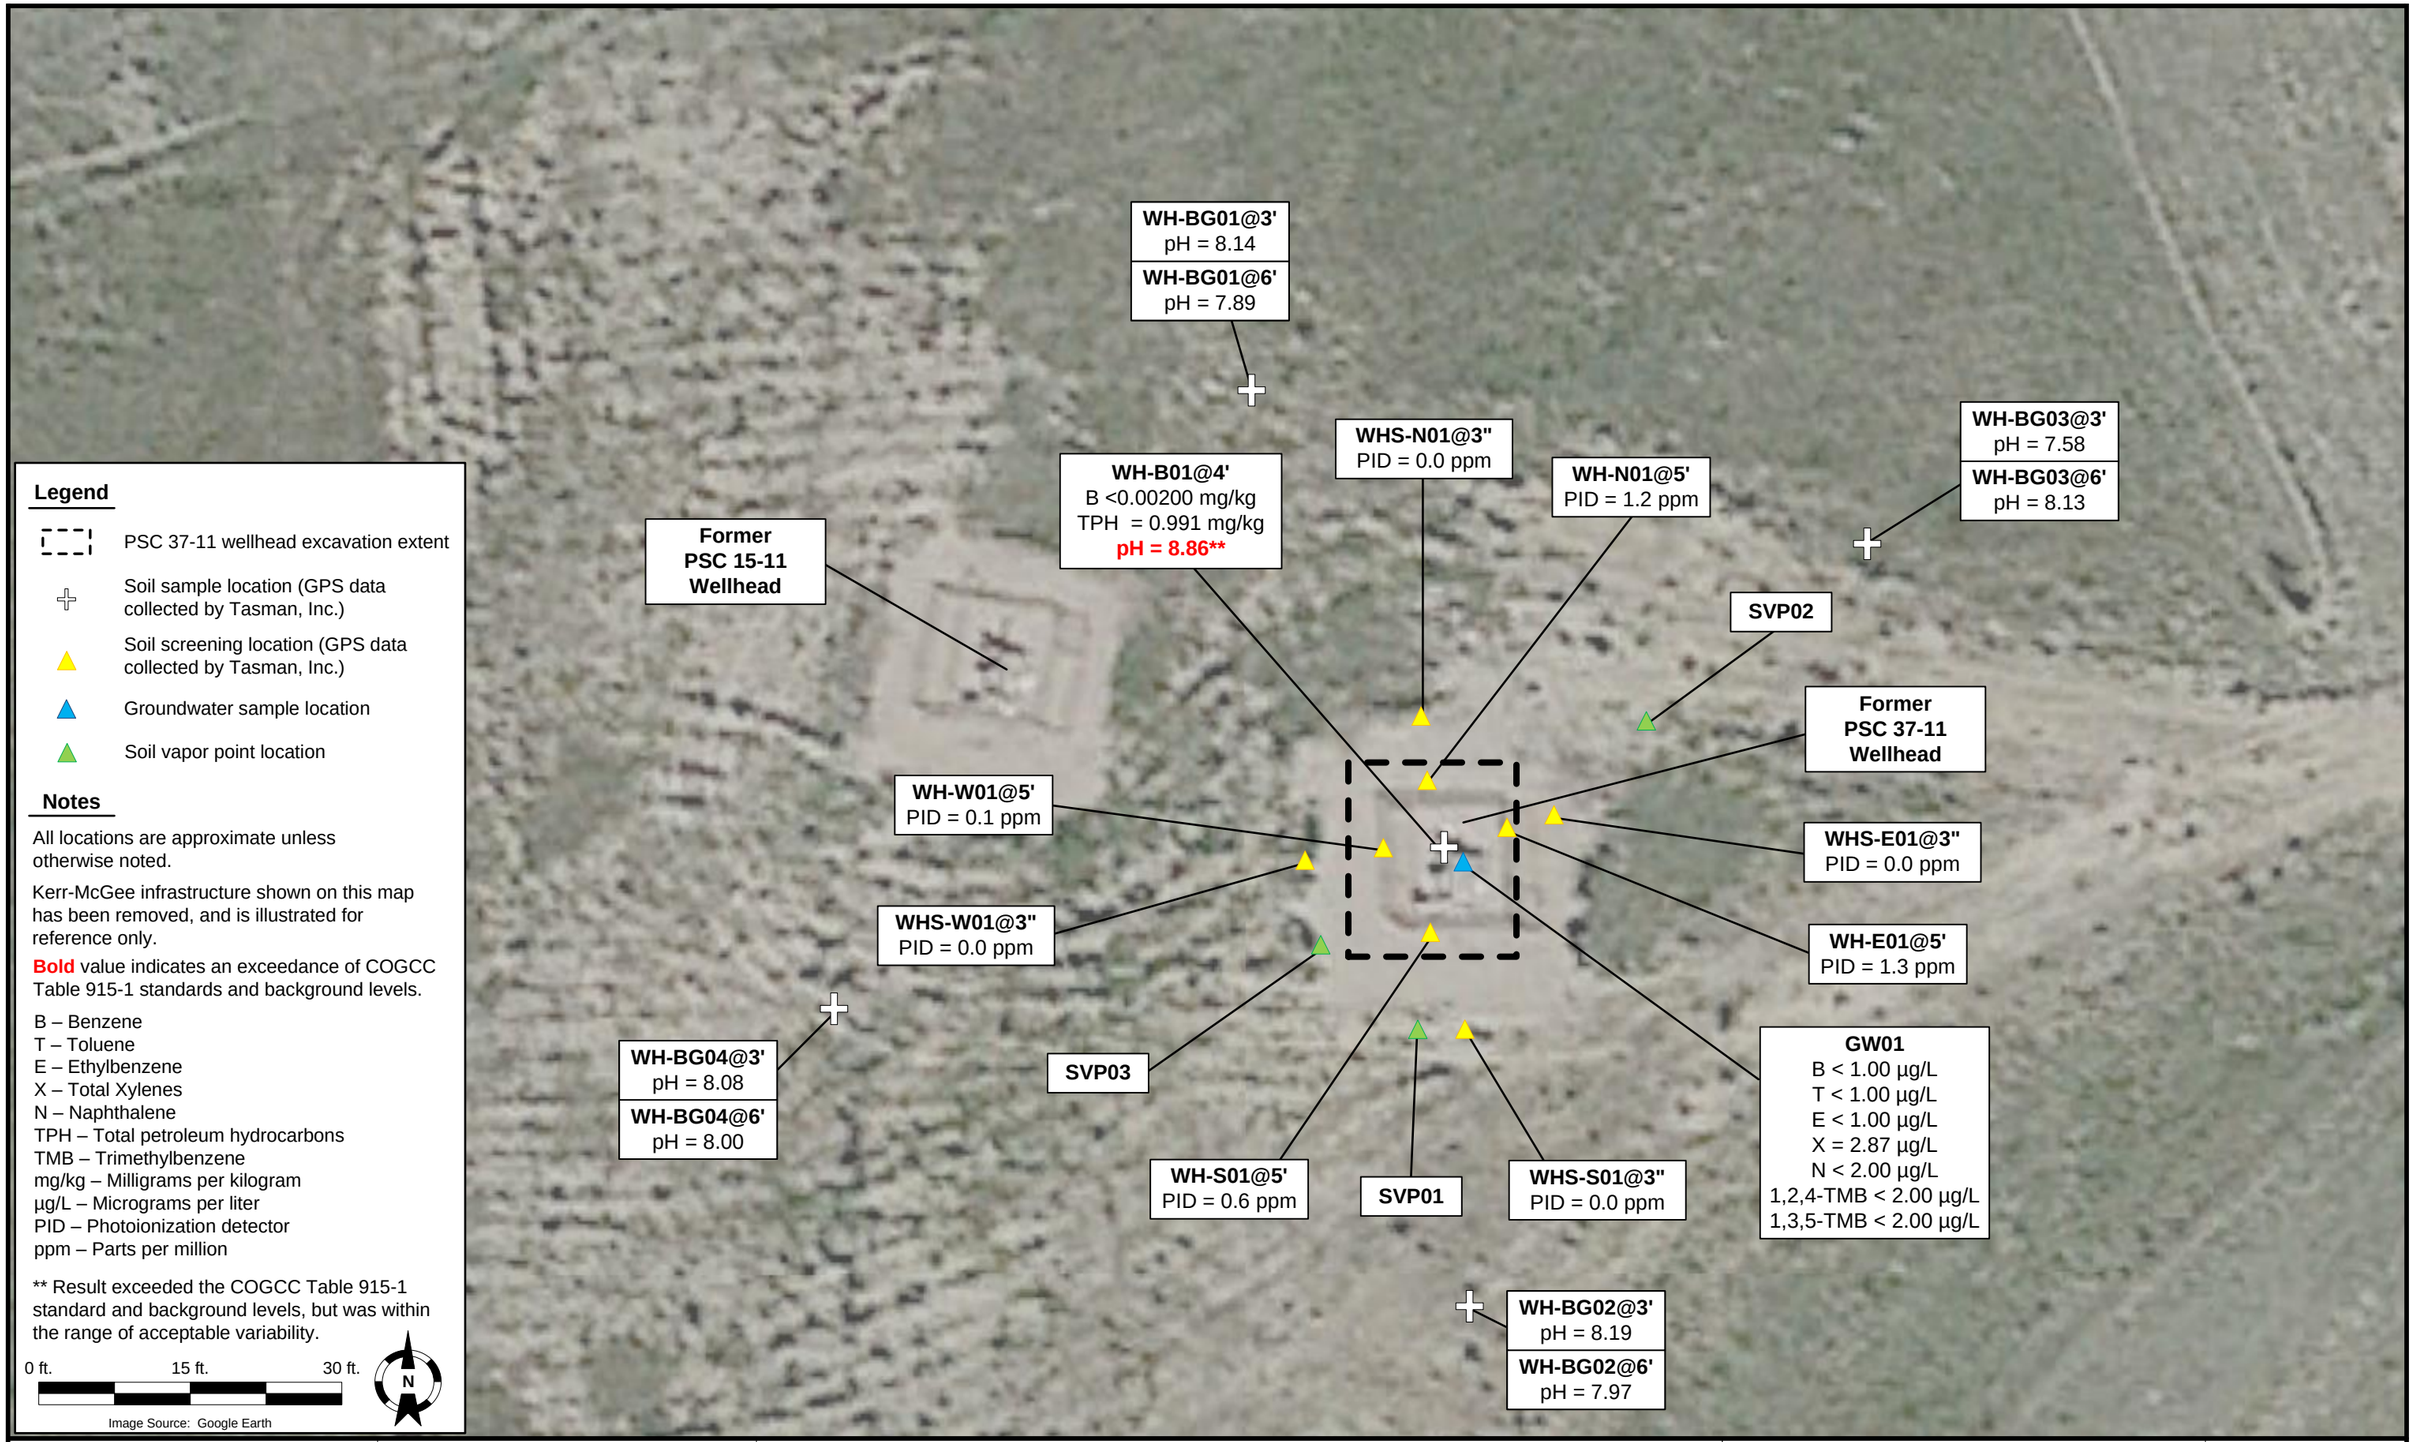

Legend

- PSC 37-11 wellhead excavation extent
- Soil sample location (GPS data collected by Tasman, Inc.)
- Soil screening location (GPS data collected by Tasman, Inc.)
- Groundwater sample location
- Soil vapor point location

Notes

All locations are approximate unless otherwise noted.

Kerr-McGee infrastructure shown on this map has been removed, and is illustrated for reference only.

Bold value indicates an exceedance of COGCC Table 915-1 standards and background levels.

B – Benzene
T – Toluene
E – Ethylbenzene
X – Total Xylenes
N – Naphthalene
TPH – Total petroleum hydrocarbons
TMB – Trimethylbenzene
mg/kg – Milligrams per kilogram
µg/L – Micrograms per liter
PID – Photoionization detector
ppm – Parts per million

** Result exceeded the COGCC Table 915-1 standard and background levels, but was within the range of acceptable variability.

0 ft. 15 ft. 30 ft.

N

Image Source: Google Earth

DATE:	February 16, 2023
DESIGNED BY:	M. Jahn
DRAWN BY:	J.Covey

TASMAN

Kerr-McGee Oil and Gas Onshore LP
PSC 15, 37-11 Wellheads
SWSE Sec. 11-T3N-R67W
Weld County, Colorado

PSC 37-11 Wellhead Screening and Sample Location Map

FIGURE 2