

Legend

- Former PSC 15, 37-11 flowline locations
- ⊕ Soil sample location (GPS data collected by Tasman, Inc.)
- ⊕ Soil sample location – above COGCC Table 915-1 soil standard (excavation pending)
- ▲ Soil screening location (GPS data collected by Tasman, Inc.)
- ▲ Groundwater sample location (GPS data collected by Tasman, Inc.)

Notes


All locations are approximate unless otherwise noted.

Kerr-McGee infrastructure shown on this map has been removed, and is illustrated for reference only.

Bold value indicates an exceedance of COGCC Table 915-1 standards and background levels.

B – Benzene
T – Toluene
E – Ethylbenzene
X – Total Xylenes
N – Naphthalene
TMB – Trimethylbenzene
M – Methylphenanthrene
As – Arsenic
Ba – Barium
Pb – Lead
Se – Selenium
SAR – Sodium Adsorption Ratio
mg/kg – Milligrams per kilogram
µg/L – Micrograms per liter
PID – Photoionization detector
ppm – Parts per million

* Result exceeded the COGCC Table 915-1 standard, but was within the range of site-specific background levels.

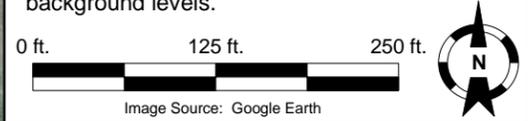

DATE: February 16, 2023

DESIGNED BY: E. Siegel

DRAWN BY: J. Covey



Kerr-McGee Oil and Gas Onshore LP
PSC 15, 37-11 Wellheads
 SWSE Sec 11-T3N-R67W
 Weld County, Colorado

Flowline Soil Screening and
 Sample Location Map

FIGURE
4