As Plugged Wellbore Schematic

Well Name	Lease	Field Name	Business Unit
Wilson Creek 65	Wilson Creek Unit	Wilson Creek	EMC
State/Province	**County/ Parish**	**Surface UWI**	**Surface ChevNo**
Colorado	Rio Blanco	0510307829	DJ7790

Current RKB Elevation	Original RKB Elevation (ft)	Ground Elevation (ft)	Current KB to Ground (ft)	Current KB to Csg Flange (ft)	Current KB to Tubing Head (ft)
8,153.00, 8/5/2013	8,153.00	8,141.00	12.00		

Original Hole [Land]

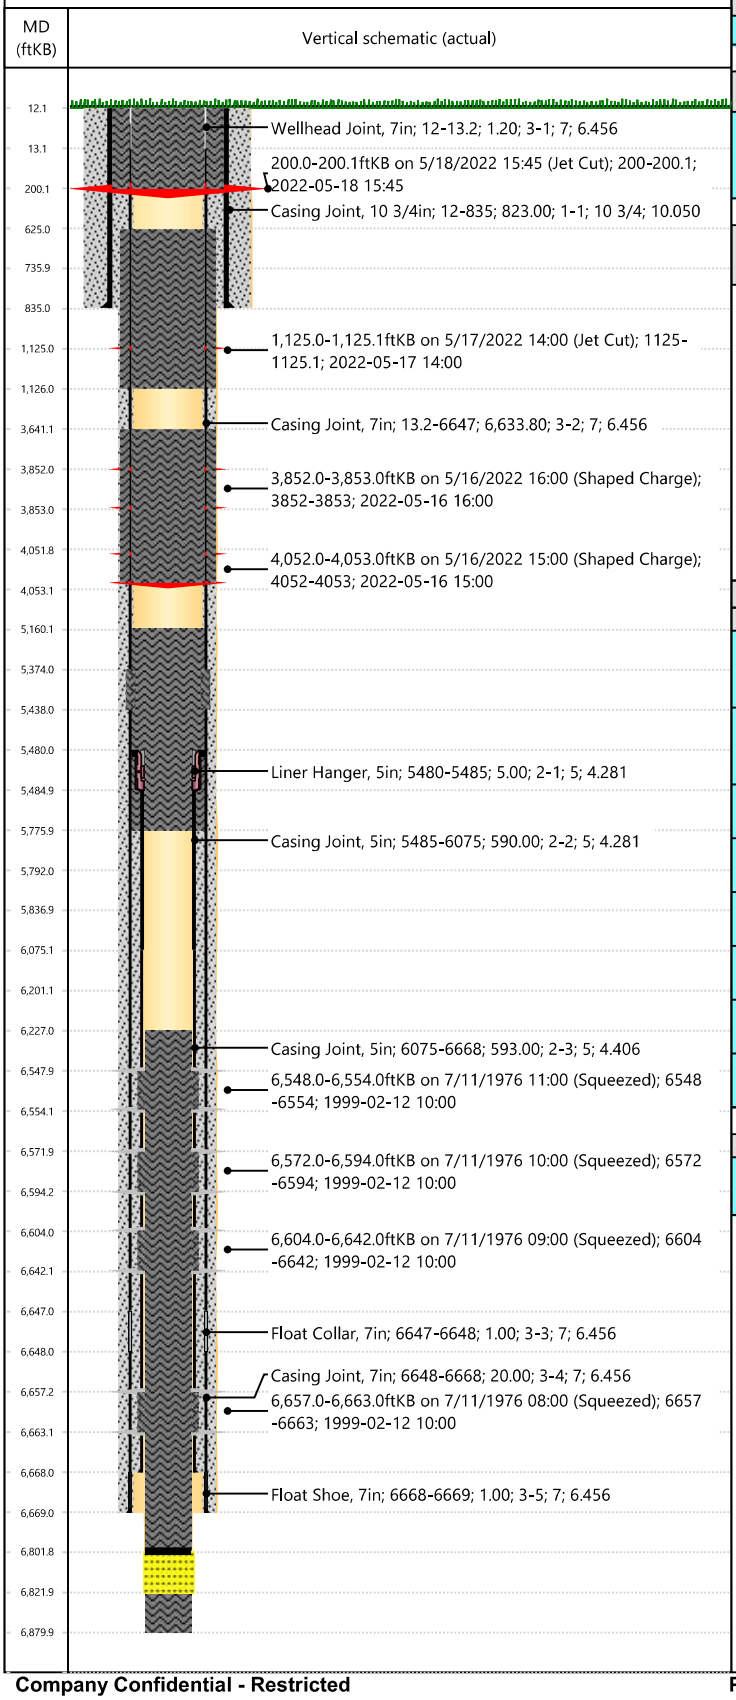

HUD & Other in Hole

Top (ftKB)	Des	OD (in)
6,802.0	Fill (Sand / Mud / Debris)	4 13/32

Casing Strings

Csg Des	OD (in)	Wt/Len (lb/ft)	Grade	Set Depth (MD) (ftKB)
Surface	10 3/4	40.50	K-55	835
Production Liner 1	5	15.00	J-55	6668
Production Casing	7	20.00	K-55	6669

Cement Plug Details

Des	Btm (ftKB)	Top (ftKB)	Class	Quantity (sacks)	Depth Tagged (MD) (ftKB)
Cement Plug	6,880.0	6,201.0	G	60	6,227
Balanced Plug (Tubing and Annulus)	6,227.0	5,837.0	G	34	5,792
Cement Plug	5,776.0	5,160.0	G	87	
Cement Squeeze	4,053.0	3,641.0	G	120	3,641
Cement Squeeze	1,126.0	625.0	G	190	736
Cement Squeeze	200.0	12.0	G	115	

Perforations

Top (ftKB)	Btm (ftKB)	Zone Name	Job	String Perforated
200.0	200.1		Abandon Well - Permanent, 5/10/2022 07:00	Production Liner 1, Actual, 6668ftKB
1,125.0	1,125.1		Abandon Well - Permanent, 5/10/2022 07:00	Production Liner 1, Actual, 6668ftKB
3,852.0	3,853.0		Drill and Complete, 6/11/1976 00:00	Production Liner 1, Actual, 6668ftKB
4,052.0	4,053.0		Drill and Complete, 6/11/1976 00:00	Production Liner 1, Actual, 6668ftKB
6,548.0	6,554.0	Morrison	Drill and Complete, 6/11/1976 00:00	Production Liner 1, Actual, 6668ftKB
6,572.0	6,594.0	Morrison	Drill and Complete, 6/11/1976 00:00	Production Liner 1, Actual, 6668ftKB
6,604.0	6,642.0	Morrison	Drill and Complete, 6/11/1976 00:00	Production Liner 1, Actual, 6668ftKB
6,657.0	6,663.0	Morrison	Drill and Complete, 6/11/1976 00:00	Production Liner 1, Actual, 6668ftKB

Zones

Zone Name	Top (ftKB)
Morrison	6,548.0
Sundance	6,669.0