As Plugged Wellbore Schematic

Well Name	Lease	Field Name	Business Unit
Wilson Creek 66	Wilson Creek Unit	Wilson Creek	EMC
State/Province	**County/ Parish**	**Surface UWI**	**Surface ChevNo**
Colorado	Rio Blanco	0510309127	FT1235

Current RKB Elevation	Original RKB Elevation (ft)	Ground Elevation (ft)	Current KB to Ground (ft)	Current KB to Csg Flange (ft)	Current KB to Tubing Head (ft)
8,234.00, 3/12/1984	8,234.00	8,214.00	20.00		

Original Hole [Land]

MD (ftKB) | Vertical schematic (actual)

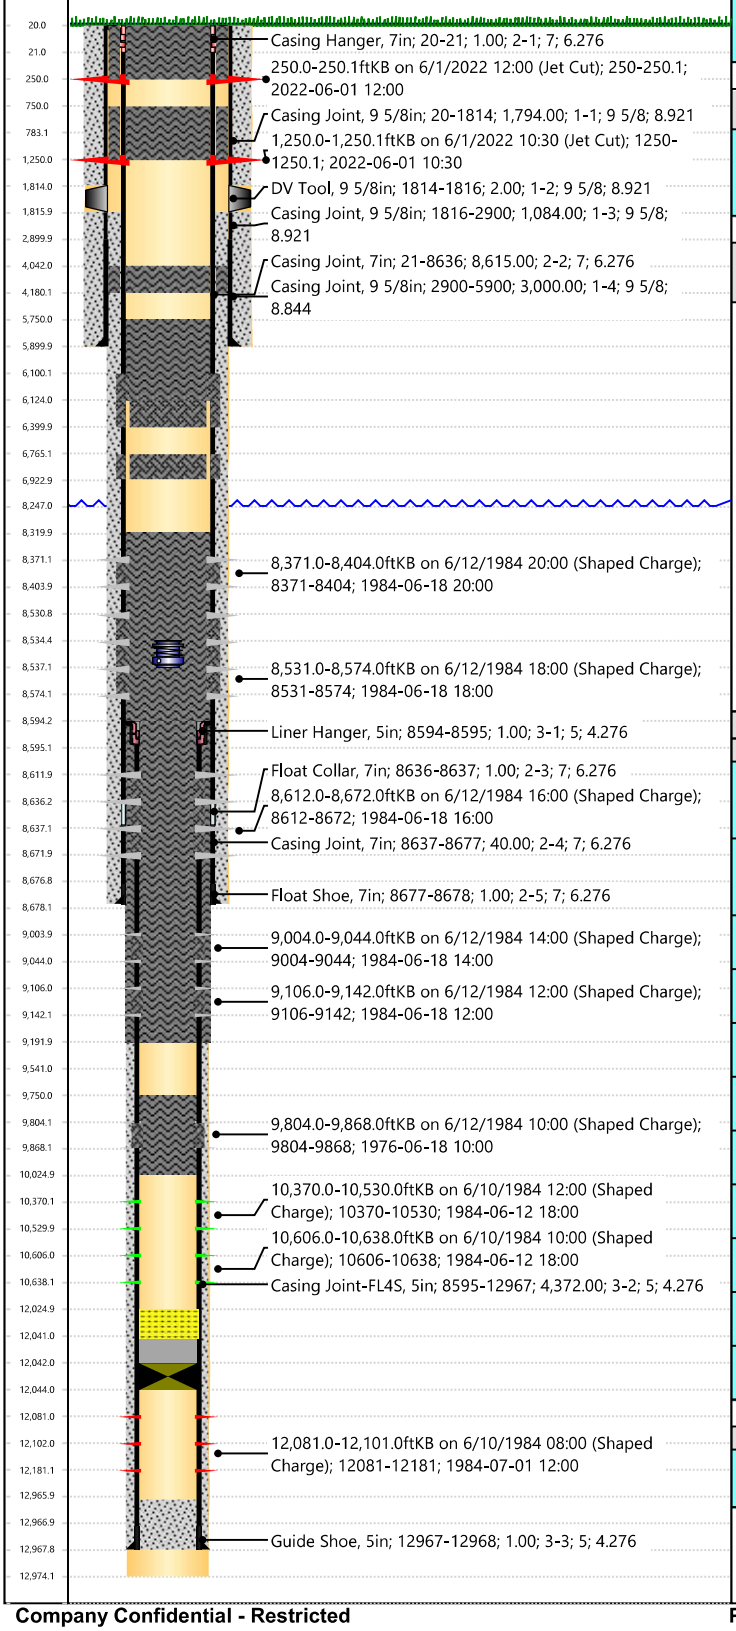

HUD & Other in Hole

Top (ftKB)	Des	OD (in)
8,534.5	Bumber Spring w/ A-Stop	2 1/4
12,025.0	Fill (Sand / Mud / Debris)	4.276
12,041.0	Cement	4.276
12,042.0	Bridge Plug (Permanent)	4.276

Casing Strings

Csg Des	OD (in)	Wt/Len (lb/ft)	Grade	Set Depth (MD) (ftKB)
Surface	9 5/8	40.00	S-95	5900
Intermediate Casing 1	7	26.00	N-80	8678
Production Casing	5	18.00	N-80	12968

Cement Plug Details

Des	Btm (ftKB)	Top (ftKB)	Class	Quantity (sacks)	Depth Tagged (MD) (ftKB)
Cement Plug	10,025.0	9,750.0	G	48	
Cement Plug	9,192.0	8,594.0	G	197	
Cement Plug	8,594.0	8,320.0	G	48	
Cement Squeeze	6,923.0	6,765.0	G	54	6,765
Cement Squeeze	6,400.0	6,100.0	G	157	6,124
Cement Squeeze	6,124.0	5,750.0	G	66	
Cement Squeeze	4,180.0	4,042.0			
Cement Squeeze	1,250.0	750.0	G	187	783
Cement Squeeze	250.0	20.0	G	192	

Perforations

Top (ftKB)	Btm (ftKB)	Zone Name	Job	String Perforated
250.0	250.1		Abandon Well - Permanent, 5/19/2022 09:30	Intermediate Casing 1, Actual, 8678ftKB
1,250.0	1,250.1		Abandon Well - Permanent, 5/19/2022 09:30	Intermediate Casing 1, Actual, 8678ftKB
8,371.0	8,404.0	Weber	Drill and Complete, 3/10/1984 06:00	Intermediate Casing 1, Actual, 8678ftKB
8,531.0	8,574.0	Weber	Drill and Complete, 3/10/1984 06:00	Intermediate Casing 1, Actual, 8678ftKB
8,612.0	8,672.0	Weber	Drill and Complete, 3/10/1984 06:00	Production Casing, Actual, 12968ftKB
9,004.0	9,044.0	Weber	Drill and Complete, 3/10/1984 06:00	Production Casing, Actual, 12968ftKB
9,106.0	9,142.0	Weber	Drill and Complete, 3/10/1984 06:00	Production Casing, Actual, 12968ftKB
9,804.0	9,868.0	Minturn	Drill and Complete, 3/10/1984 06:00	Production Casing, Actual, 12968ftKB
10,370.0	10,530.0	Minturn	Drill and Complete, 3/10/1984 06:00	Production Casing, Actual, 12968ftKB
10,606.0	10,638.0	Minturn	Drill and Complete, 3/10/1984 06:00	Production Casing, Actual, 12968ftKB
12,081.0	12,101.0	Minturn	Drill and Complete, 3/10/1984 06:00	Production Casing, Actual, 12968ftKB

Zones

Zone Name	Top (ftKB)
Weber	8,247.0
Minturn	9,541.0