


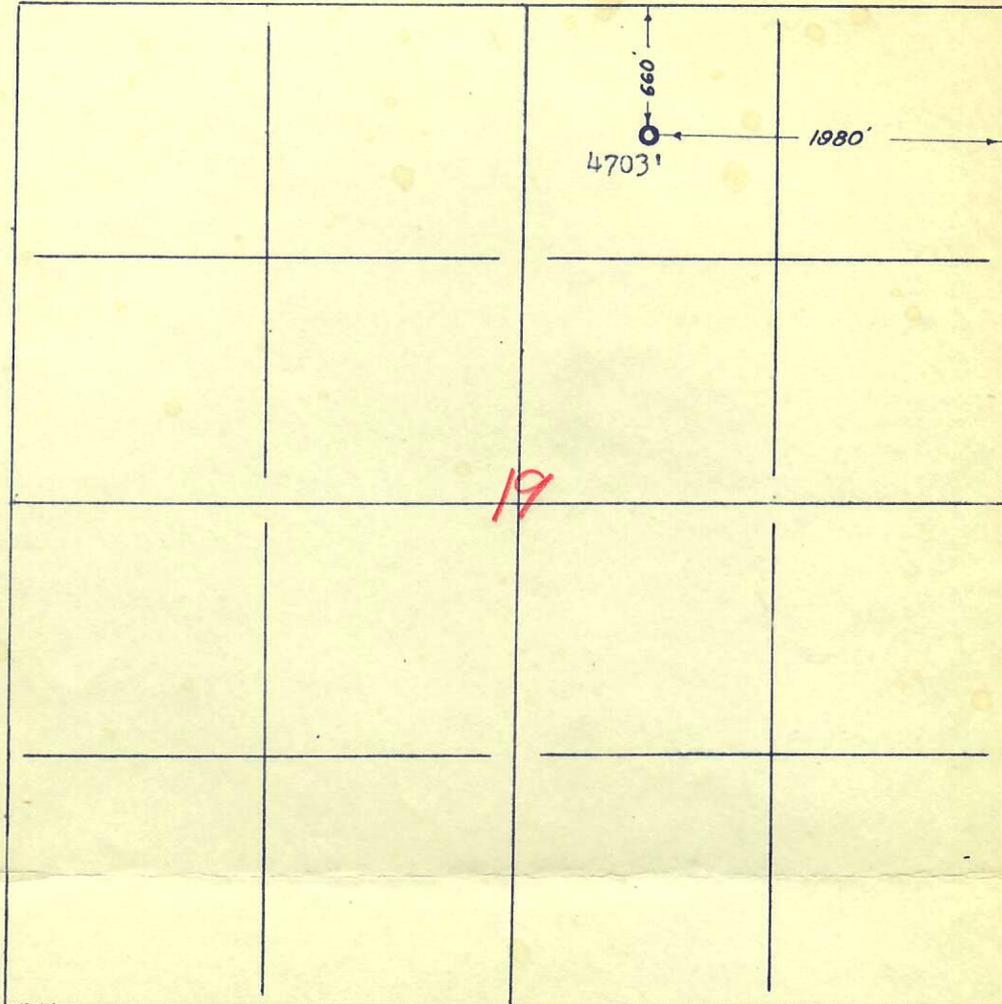

00325775

CERTIFICATE of SURVEY
For
THE CHICAGO CORPORATION
#2 Frank Landaker

LOCATION: C-NW $\frac{1}{4}$ NE $\frac{1}{4}$ Section 19 T-3-S, R-55-W ELEVATION: 4703 Gr.



I, Arthur Todd, a registered
land surveyor in the State of Colorado, do hereby
certify that the above plat is a correct delineation
of the survey made by me the 7th of November, 1956.

RECEIVED
NOV 9 1956

MINING & GAS
CONSERVATION COMMISSION
REGISTERED SURVEYOR
ARTHUR TODD
2058
WHEAT RIDGE, COLO.

TODD ENGINEERING CO.
4380 Wadsworth
WHEAT RIDGE, COLO.

Arthur Todd