

DEPARTMENT OF NATURAL RESOURCES
OIL AND GAS CONSERVATION COMMISSION
OF THE STATE OF COLORADO

00416038

RECEIVED

JUL 29 1976

APPLICATION
FOR PERMIT TO DRILL, DEEPEN, OR REENTER AND OPERATE

1a. TYPE OF WORK

DRILL ☒DEEPEN ☐REENTER AND OPERATE ☐

b. TYPE OF WELL

OIL
WELL ☒GAS
WELL ☐OTHER ☐SINGLE
ZONE ☒MULTIPLE
ZONE ☐

2. NAME OF OPERATOR

Keba Oil & Gas Company - ~~Exeter~~

PHONE NO.

303-458-1976

3. ADDRESS OF OPERATOR

2460 W. 26th Ave., 30C, Denver, CO 80211

4. LOCATION OF WELL (Report location clearly and in accordance with any State requirements.)

At surface

C NW/4NW/4
At proposed prod. zone

same as above

14. DISTANCE IN MILES AND DIRECTION FROM NEAREST TOWN OR POST OFFICE

3 miles north of Last Chance, Colorado

15. DISTANCE FROM PROPOSED LOCATION TO NEAREST PROPERTY
OR LEASE LINE, FT.
(Also to nearest drlg. line, if any)

660'

16. NO. OF ACRES IN LEASE*

960

17. NO. OF ACRES AND/OR DRILLING UNIT ASSIGNED
TO THIS WELL

40

18. DISTANCE FROM PROPOSED LOCATION
TO NEAREST WELL, DRILLING, COMPLETED,
OR APPLIED FOR, ON THIS LEASE, FT.

19. PROPOSED DEPTH

4975'

20. ROTARY OR CABLE TOOLS

Rotary

21. ELEVATIONS (Show whether DF, RT, GR, etc.)

4772 GR

22. APPROX. DATE WORK WILL START

8-20-76

23.

PROPOSED CASING AND CEMENTING PROGRAM

SIZE OF HOLE	SIZE OF CASING	WEIGHT PER FOOT	SETTING DEPTH	QUANTITY OF CEMENT
12-1/2"	8-5/8"	20#	120'	130 sacks
7-7/8"	5-1/2"	14#	4975'	150 sacks

*DESCRIBE LEASE

S/2 Sec. 17 and all of Sec. 20, T3S-R55W

(Exeter Drilling Company Blanket Bond)

ALLISON

DVR	
FJP	<input checked="" type="checkbox"/>
HHM	<input checked="" type="checkbox"/>
JAM	<input checked="" type="checkbox"/>
JJD	Plotted
GCH	
COM	

Keba ck. 2809

IN ABOVE SPACE DESCRIBE PROPOSED PROGRAM: If proposal is to deepen or reenter and operate, give data on present productive zone and proposed new productive zone. If proposal is to drill or deepen directionally, give pertinent data on subsurface locations and measured and true vertical depths. Give blowout preventer program, if any.

In accepting this permit the applicant agrees to fully abide by the requirements and rules of this Commission governing this permitted operation including his responsibility to prevent pollution of state waters during drilling, treating, testing, and producing operations and by the casing, cementing and plugging requirements particularly designed for the protection of state waters and the prevention of intermingling of the contents of all the various zones encountered in this permitted operation.

24.

SIGNED

TITLE

President

DATE

7-28-76

(This space for Federal or State Office use)

PERMIT NO.

76 674

APPROVAL DATE

DIRECTOR

APPROVED BY

TITLE

O & G CONS. COMM.

DATE

JUL 30 1976

CONDITIONS OF APPROVAL, IF ANY:

See Instructions On Reverse Side

A.P.I. NUMBER


05 121 9156

76-674

CERTIFICATE OF SURVEY
for
Keba Oil and Gas Co.
Washington County, Colorado

RECEIVED
JUL 29 1976
COLO. OIL & GAS CONS. COMM.

T 3 S R 55 W 6 PM

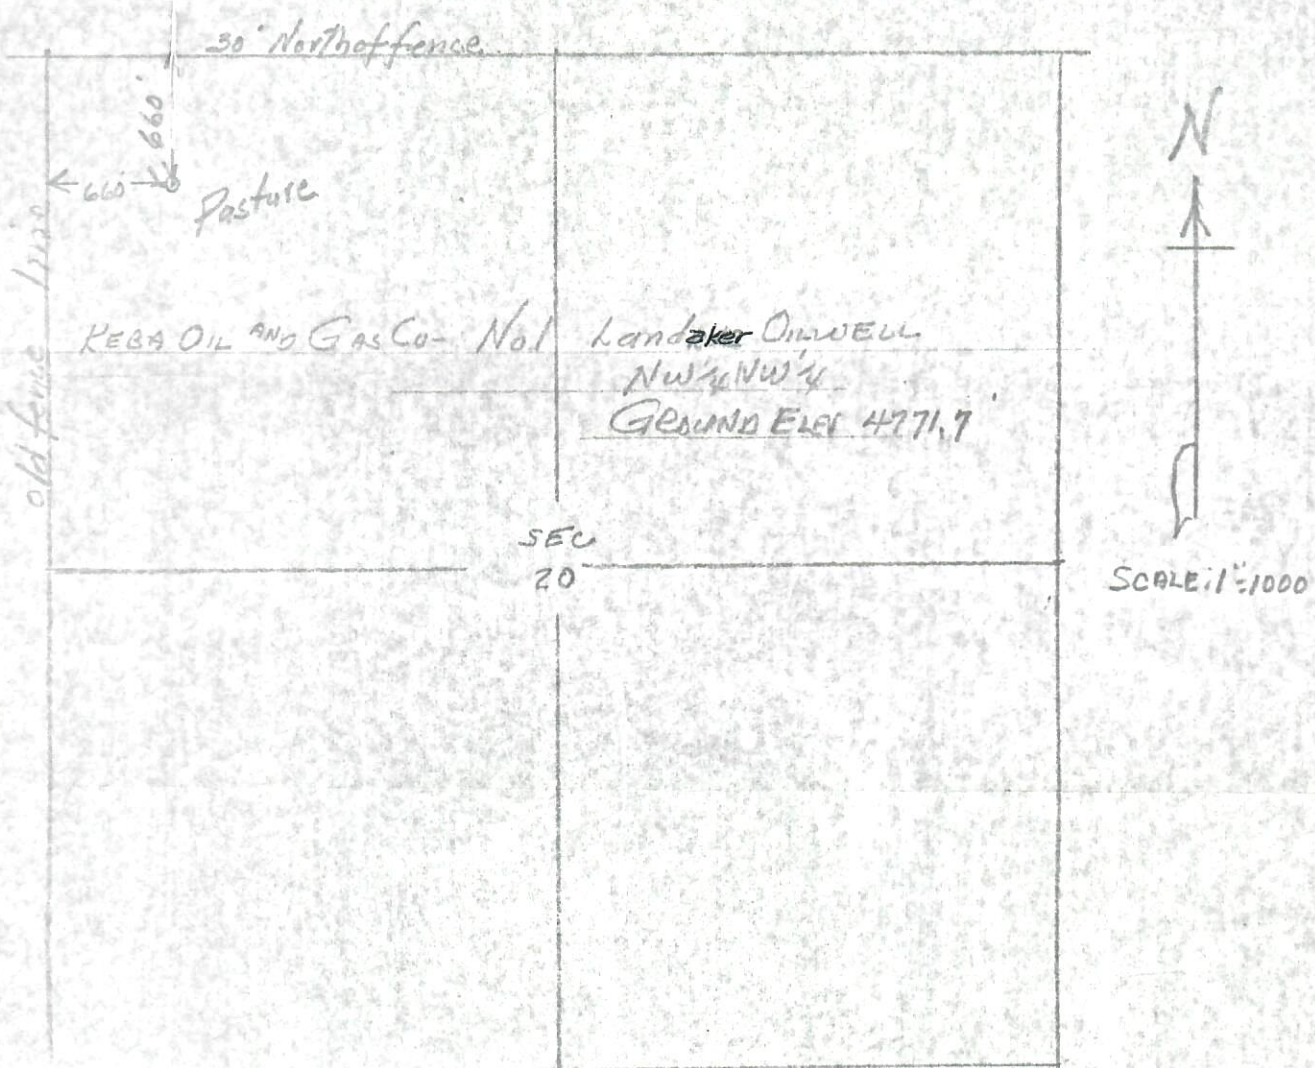

I hereby certify that the above plat is an accurate representation of a correct survey showing the location of Keba Oil and Gas Co.- No.1 Landaker Oilwell in NW 1/4 Sec. 20 T3S R55W 6PM. The elevation of the ground at the stake is 4771.7 feet above sea level from U.S.C.&G. Bench Mark.

Fort Morgan, Colorado
July 26, 1976

Facil J. Osborne
Registered Professional Engineer
State of Colorado

76 674