




99999999

R. 56 W

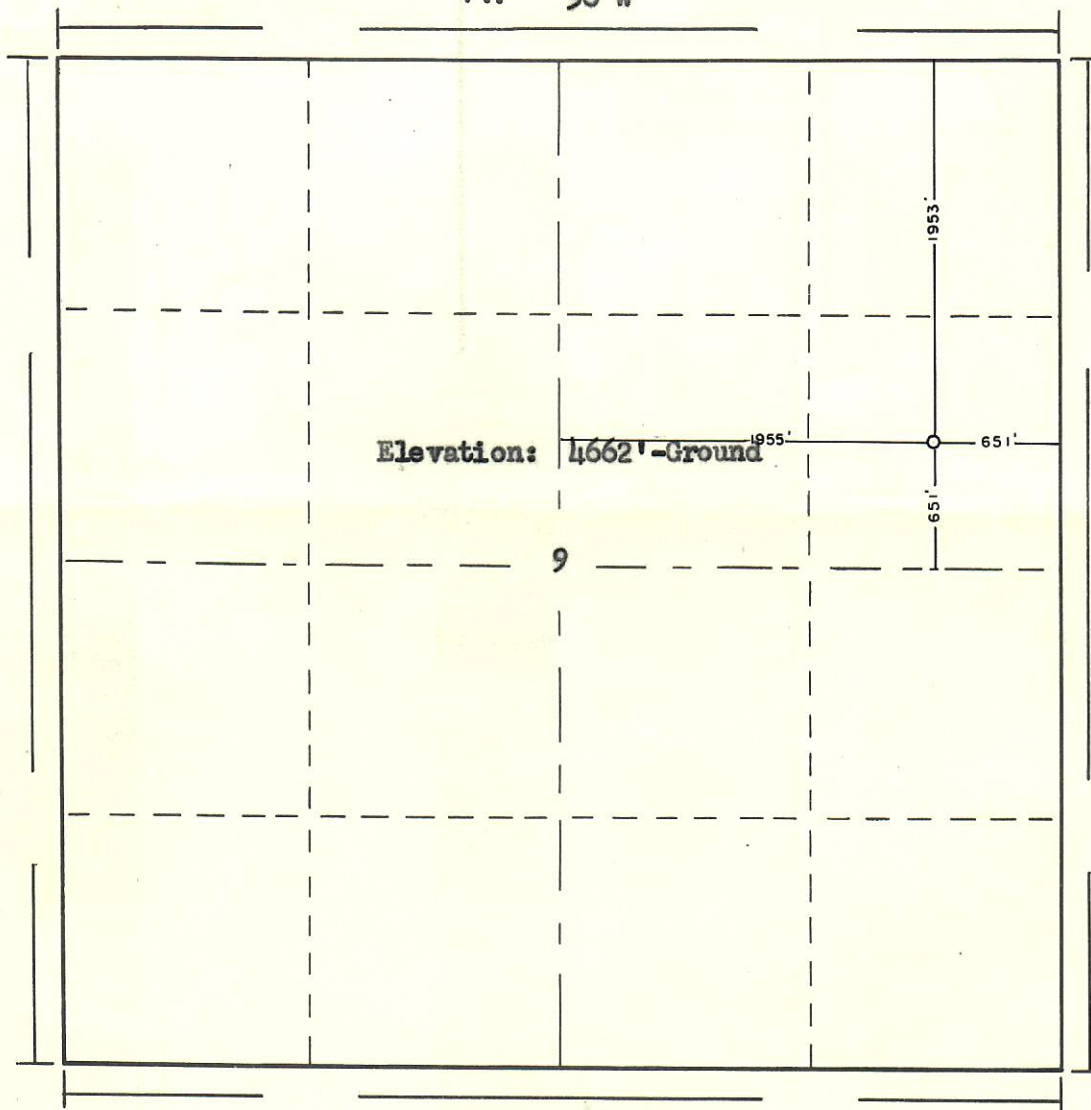


T.

3

S

Scale ... 1" = 1000'

Powers Elevation Company of Casper, Wyoming
has in accordance with a request from Mr. Hershallman
for Chicago Corp.-Republic Natural Gas & Shell determined the
Location of #1 High-Jolly
to be C SE NE Section 9 Township 3 South
Range 56 West 6th Principal Meridian
Washington County, Colorado
The above Plat shows the location of the well site
in said section.

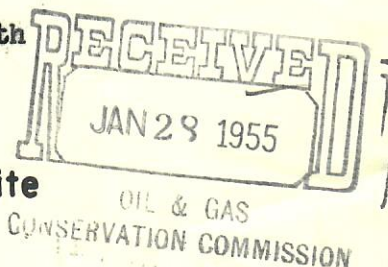

Powers Elevation Company

by: *Bruce Seibert*

Date: 1-26-55

Registered Land Surveyor



00229687