




RECEIVED

APR 21 1970

COLO. OIL & GAS CONS. COMM.

R. 56W

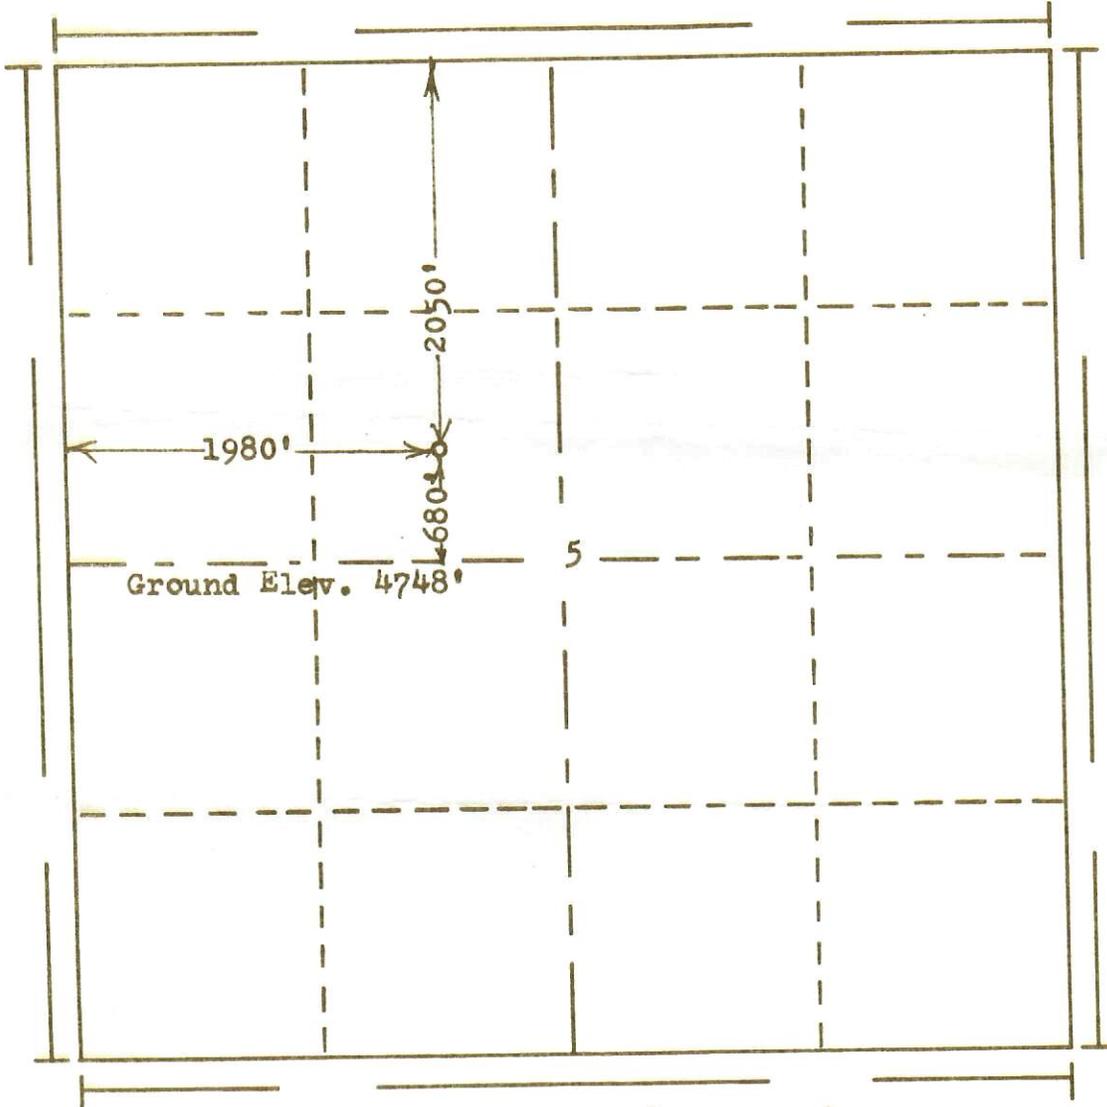

T. 3S

Scale... 1" = 1000'

Powers Elevation Company, Inc. of Denver, Colorado
 has in accordance with a request from Mr. Sidwell
 for William A. Sidwell

determined the location of No.1 Downing
 to be CSE NW Section 5 Township 3S
 Range ~~56W~~ 56W of the 6th Principal Meridian
Washington County, Colorado

I hereby certify that this plat is an
 accurate representation of a correct
 survey showing the location of

Date: 4-16-70

Eric J. Hollen
 Licensed Land Surveyor No. 2853
 State of Colorado