

121-05732




99999999

CERTIFICATE OF SURVEY  
for  
Continental Oil Co.

T3S R56W 6 P.M.

RECEIVED  
JAN 10 1956  
OIL & GAS  
CONSERVATION COMMISSION

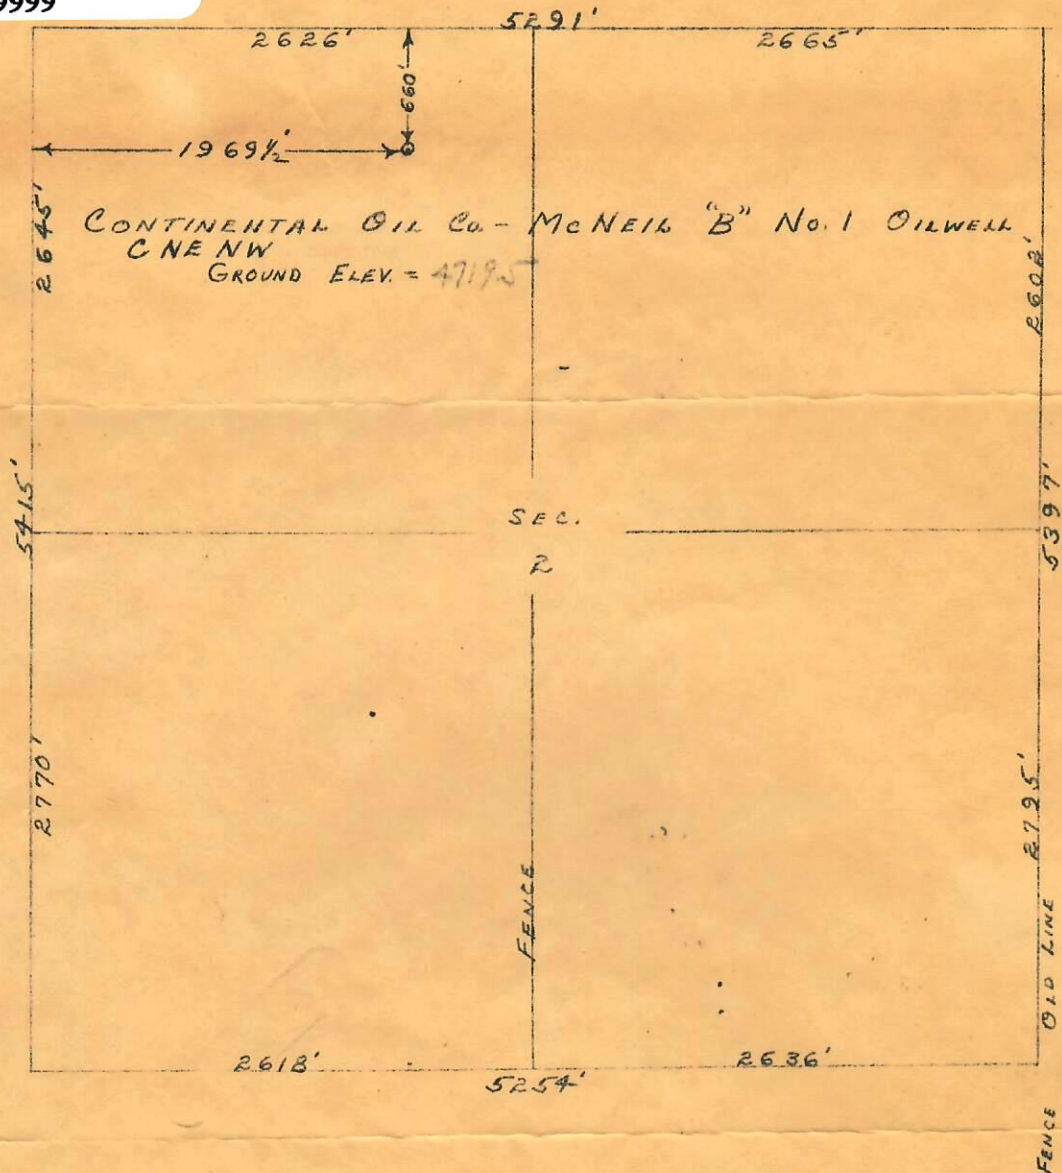

I hereby certify that the above plat is an accurate representation of a correct survey showing the location of Continental Oil Co. - McNeil "B" No. 1 Oilwell located in the C NE NW Sec. 2 T3S R56W 6 P.M. The elevation of the ground at the stake is 4719.5 feet above sea level from U.S.C.G.S. Bench Mark.

Fort Morgan, Colorado  
December 24, 1955

*Cecil J. Osborne*  
Registered Professional Engineer  
State of Colorado



00834419