

Colo Cons Com




CERTIFICATE OF SURVEY
for
Patrick A. Doheny
Washington County, Colorado

RECEIVED:

APR - 7 1969

COLO. OIL & GAS CONS. COMM.

T3S R55W 6PM.

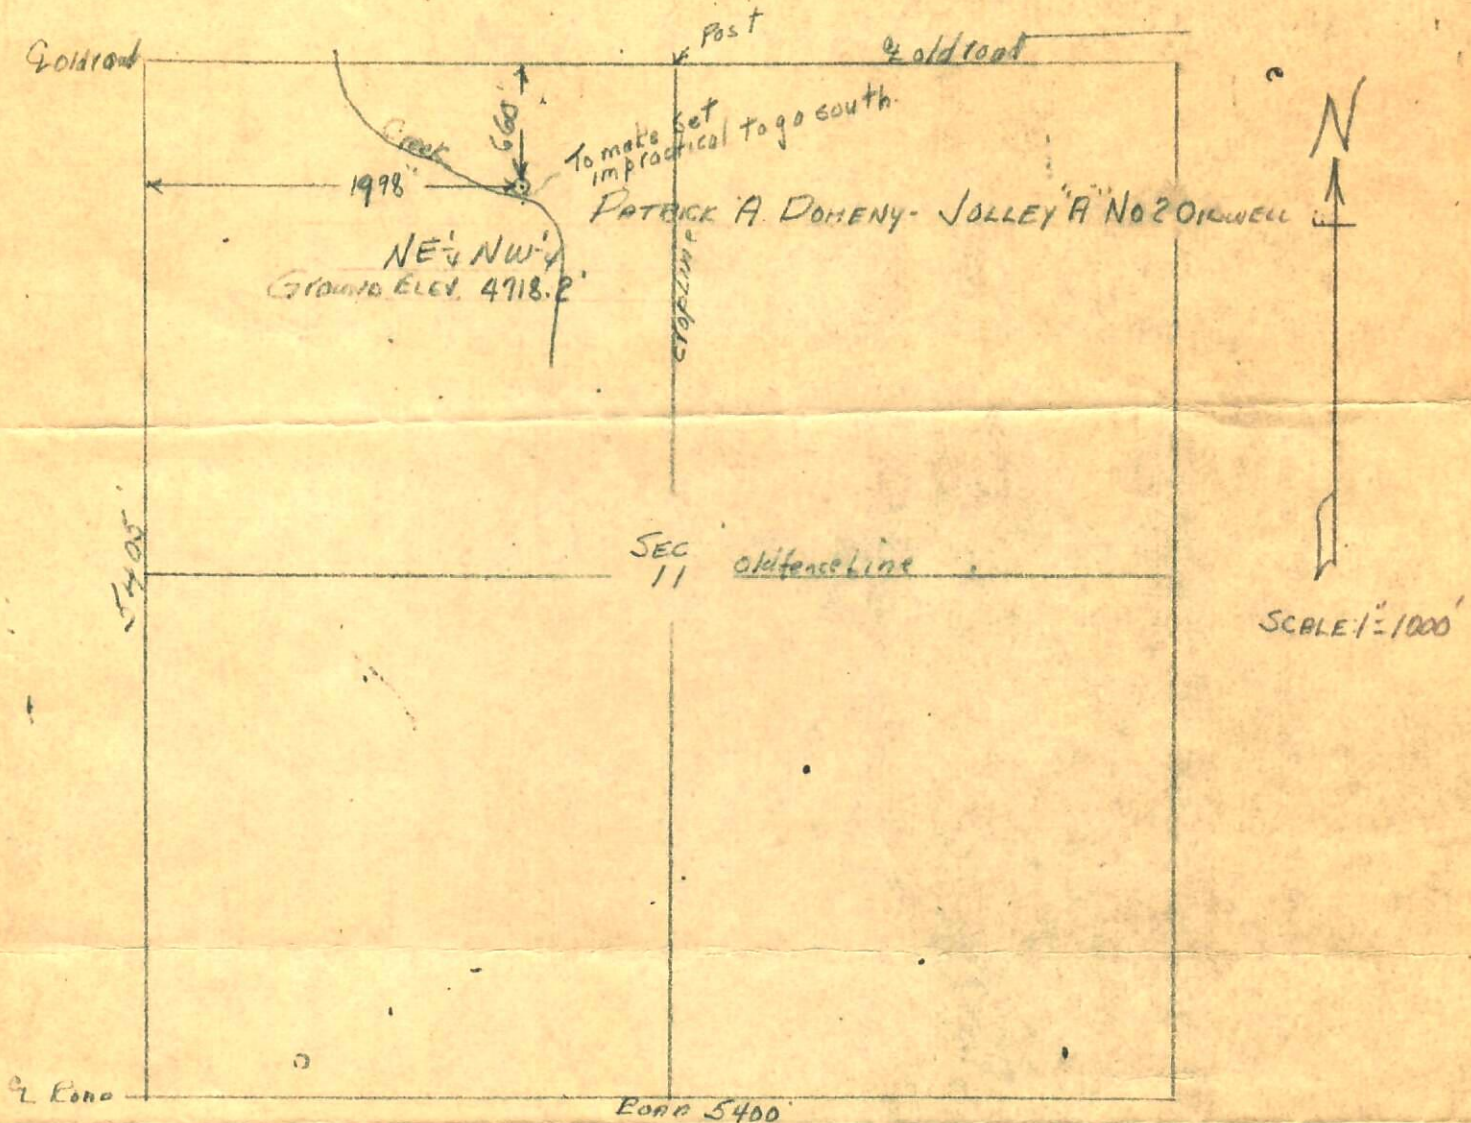

I hereby certify that the above plat is an accurate representation of a correct survey showing the location of Patrick A. Doheny- Jolley "A" No. 2 Oilwell in NE 1/4 NW 1/4 Sec. 11 T3S R55W 6PM. The elevation of the ground at the stake is 4718.2 feet above sea level from U.S.C.&G. Bench Mark.

Fort Morgan, Colorado
March 26, 1969

David J. Carson
Registered Professional Engineer
State of Colorado

69-121