




00400508

RECEIVED

NOV 6 1968

R.55 W

COLO. OIL & GAS CONS. COMM.

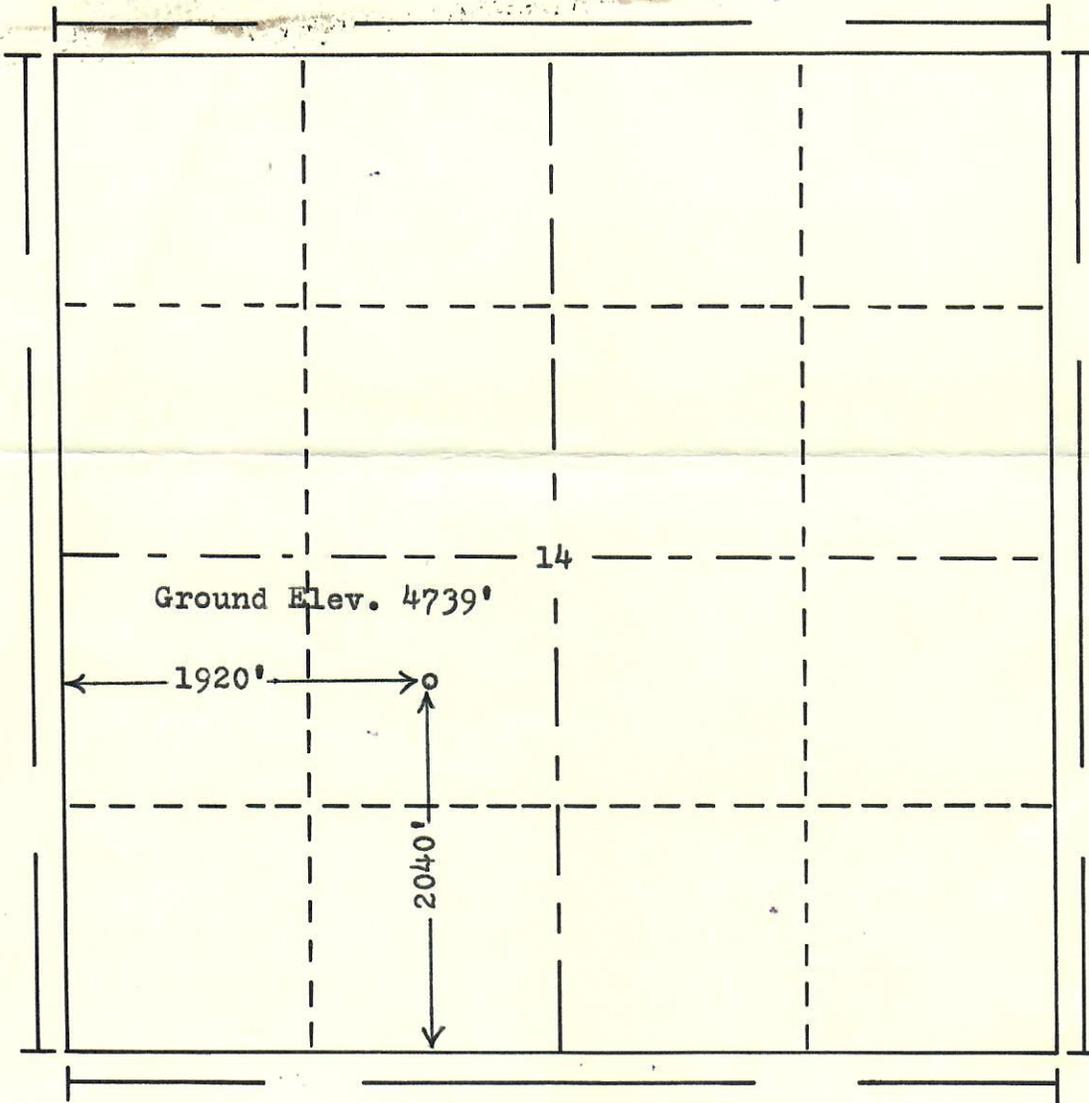

T.
3
S

Scale... 1" = 1000'

Powers Elevation Company, Inc. of Denver, Colorado
 has in accordance with a request from Mr. Brown
 for Curran & Co.

determined the location of No.23-14 Hass
 to be 1920'FW & 2040'FS Section 14 Township 3 South
 Range 55 West of the 6th Principal Meridian
 Washington County, Colorado

I hereby certify that this plat is an
 accurate representation of a correct
 survey showing the location of

Date: 11-2-68

Billy G. Holloway

Licensed Land Surveyor No.2853
 State of Colorado

