



81-7605


RECEIVED

SEP 18 1981

COLO. OIL & GAS CONS. COM.M.



R. 55W

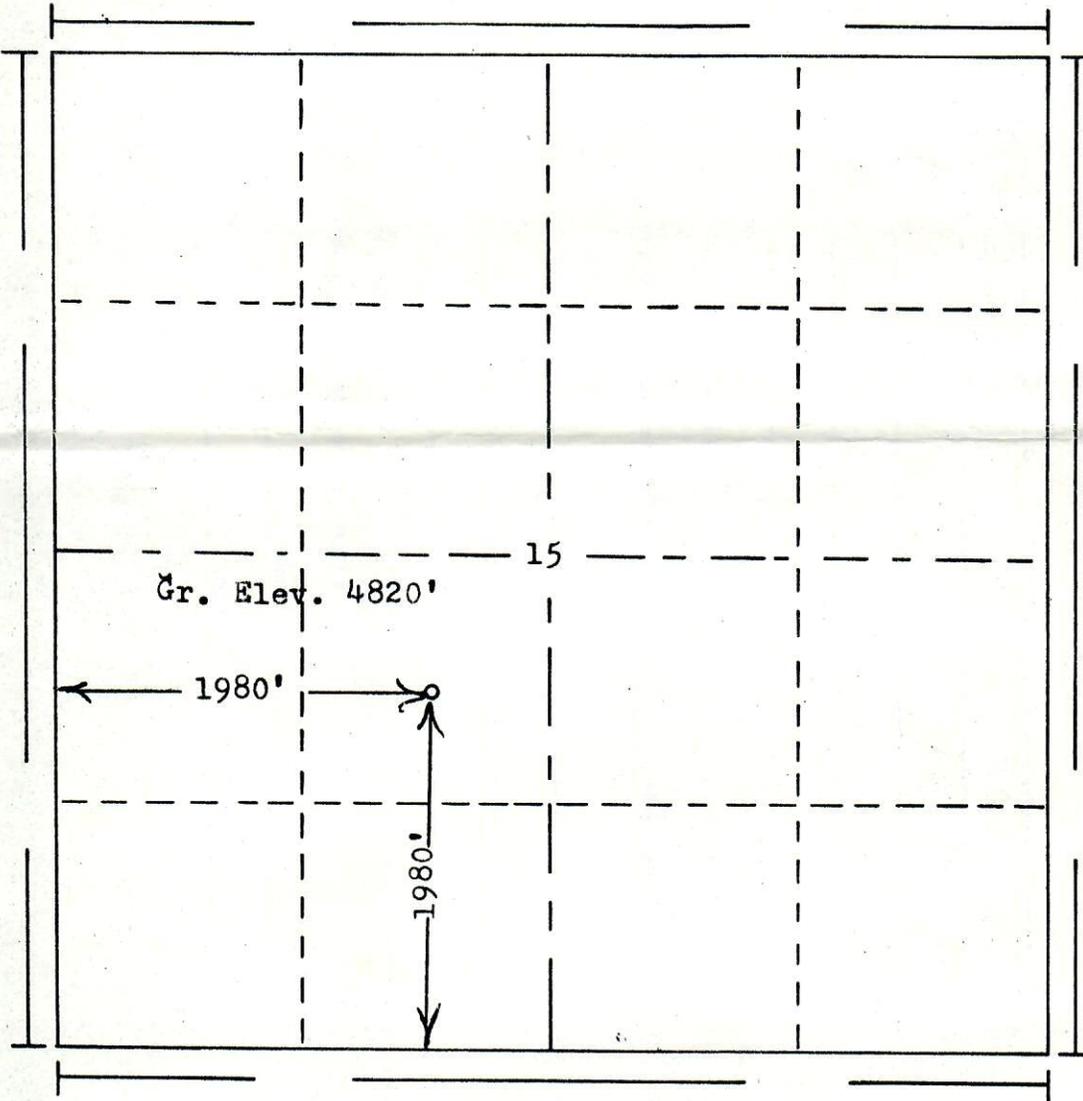

T. 3S

Scale... 1" = 1000'

**Powers Elevation of Denver, Colorado**  
 has in accordance with a request from Mr. Nylund  
 for J.W. Nylund  
 determined the location of No.1 Hass  
 to be CNE SW Section 15 Township 3S  
 Range 55W of the 6th Principal Meridian  
Washington County, Colorado

I hereby certify that this plat is an  
 accurate representation of a correct  
 survey showing the location of

Date: 9-11-81

Ray J. Hagan  
 Licensed Land Surveyor No. 2853  
 State of Colorado

RECEIVED

SEP 17 1981

SEP 17 1981



10/27/83

Plugging description  
not complete -  
Called for revised rept.

H.

Hold for rept nhl

SEP 17 1981