




00400522

RECORDED  
JUL 22 1966

R. 55W

OIL & GAS  
CONSERVATION COMMISSION

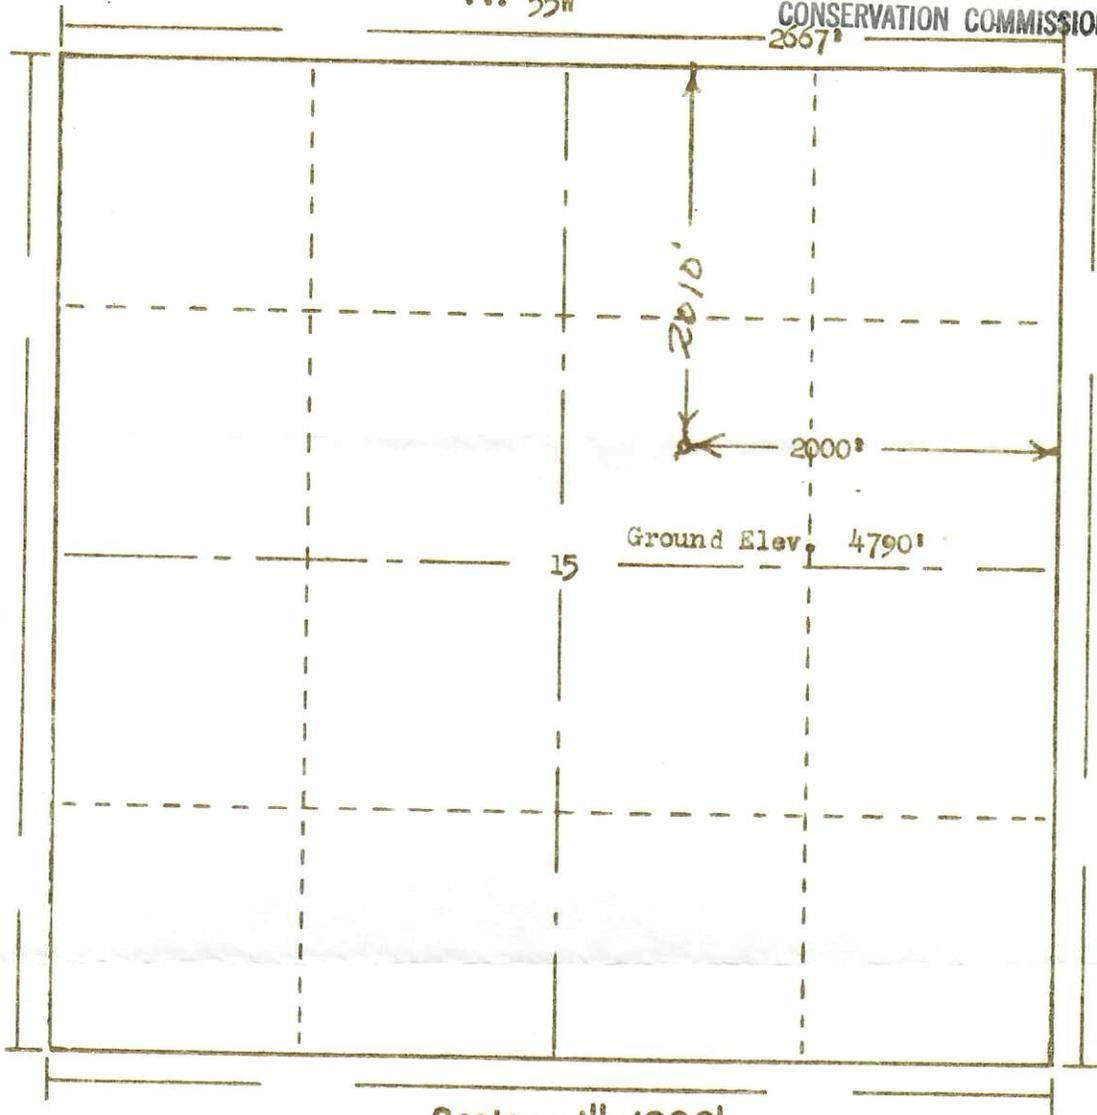

T.  
3  
S

Scale ... 1" = 1000'

Powers Surveyors, Inc. of Denver, Colorado  
has in accordance with a request from Mr. Lowe  
for Consolidated Oil & Gas Inc. determined the

Location of No. 1-B Hass  
to be CSW NE Section 15 Township 38  
Range 55W of the 6th Principal Meridian  
Washington County, Colorado

I hereby certify that this plat is an  
accurate representation of a correct  
survey showing the location of

Date: 7-25-66

Bill G. Holloway  
Licensed Land Surveyor No. 8553  
State of Colorado