

DEPARTMENT OF NATURAL RESOURCES
OIL AND GAS CONSERVATION COMMISSION
OF THE STATE OF COLORADO

RECEIVED

JAN 18 1982

00400563

APPLICATION
FOR PERMIT TO DRILL, DEEPEN, OR REENTER AND OPERATE

1a. TYPE OF WORK

DRILL ☒DEEPEN ☐REENTER AND OPERATE ☐

b. TYPE OF WELL

OIL
WELL ☒GAS
WELL ☐OTHER ☐SINGLE
ZONE ☒MULTIPLE
ZONE ☐

2. NAME OF OPERATOR

KEBA OIL & GAS COMPANY

PHONE NO.

(303) 458-1976

3. ADDRESS OF OPERATOR

2460 W. 26th Avenue, #30C Denver, Colorado 80211

4. LOCATION OF WELL (Report location clearly and in accordance with any State requirements.)

At surface

660' FNL 760' FWL NW NW Section 16-3S-55W

At proposed prod. zone

Same

14. DISTANCE IN MILES AND DIRECTION FROM NEAREST TOWN OR POST OFFICE

4 1/4 miles NE of LAST CHANCE, COLORADO

15. DISTANCE FROM PROPOSED LOCATION TO NEAREST PROPERTY OR LEASE LINE, FT.
(Also to nearest drlg. line, if any)

660'

16. NO. OF ACRES IN LEASE*

320

17. NO. OF ACRES AND OR DRILLING UNIT ASSIGNED TO THIS WELL

40

18. DISTANCE FROM PROPOSED LOCATION TO NEAREST WELL, DRILLING, COMPLETED, OR APPLIED FOR, ON THIS LEASE, FT.

—

19. PROPOSED DEPTH

5000

20. ROTARY OR CABLE TOOLS

ROTARY

21. ELEVATIONS (Show whether DF, RT, GR, etc.)

4705 GR

22. APPROX. DATE WORK WILL START

1-17-82

23.

PROPOSED CASING AND CEMENTING PROGRAM

SIZE OF HOLE	SIZE OF CASING	WEIGHT PER FOOT	SETTING DEPTH	QUANTITY OF CEMENT
12 1/4"	8 5/8"	24#	120'	Circulate to surface
7 7/8"	5 1/2"	14#	5000	125 sax

* DESCRIBE LEASE

State lease 74-7341-S covering N/2 Section 16, 3S-55W

IN ABOVE SPACE DESCRIBE PROPOSED PROGRAM: If proposal is to deepen or reenter and operate, give data on present productive zone and proposed new productive zone. If proposal is to drill or deepen directionally, give pertinent data on subsurface locations and measured and true vertical depths. Give blowout preventer program, if any.

In accepting this permit the applicant agrees to fully abide by the requirements and rules of this Commission governing this permitted operation including his responsibility to prevent pollution of state waters during drilling, treating, testing, and producing operations and by the casing, cementing and plugging requirements particularly designed for the protection of state waters and the prevention of intermingling of the contents of all the various zones encountered in this permitted operation.

24.

SIGNED

Charles B. Davis

TITLE OPERATIONS ASSISTANT

DATE 1-15-82

(This space for Federal or State Office use)

PERMIT NO.

82 65

APPROVAL DATE

Exp.

MAY 19 1982

APPROVED BY

M. Rogers

TITLE

DIRECTOR
O & G Cons. Comm.

DATE

JAN 19 1982

CONDITIONS OF APPROVAL, IF ANY:

See Instructions On Reverse Side

A.P.I. NUMBER

05 121 9764




FORM F-105

RECEIVED

JAN 18 1982

SOLD. OIL & GAS CONS. COMM.

R. 55W

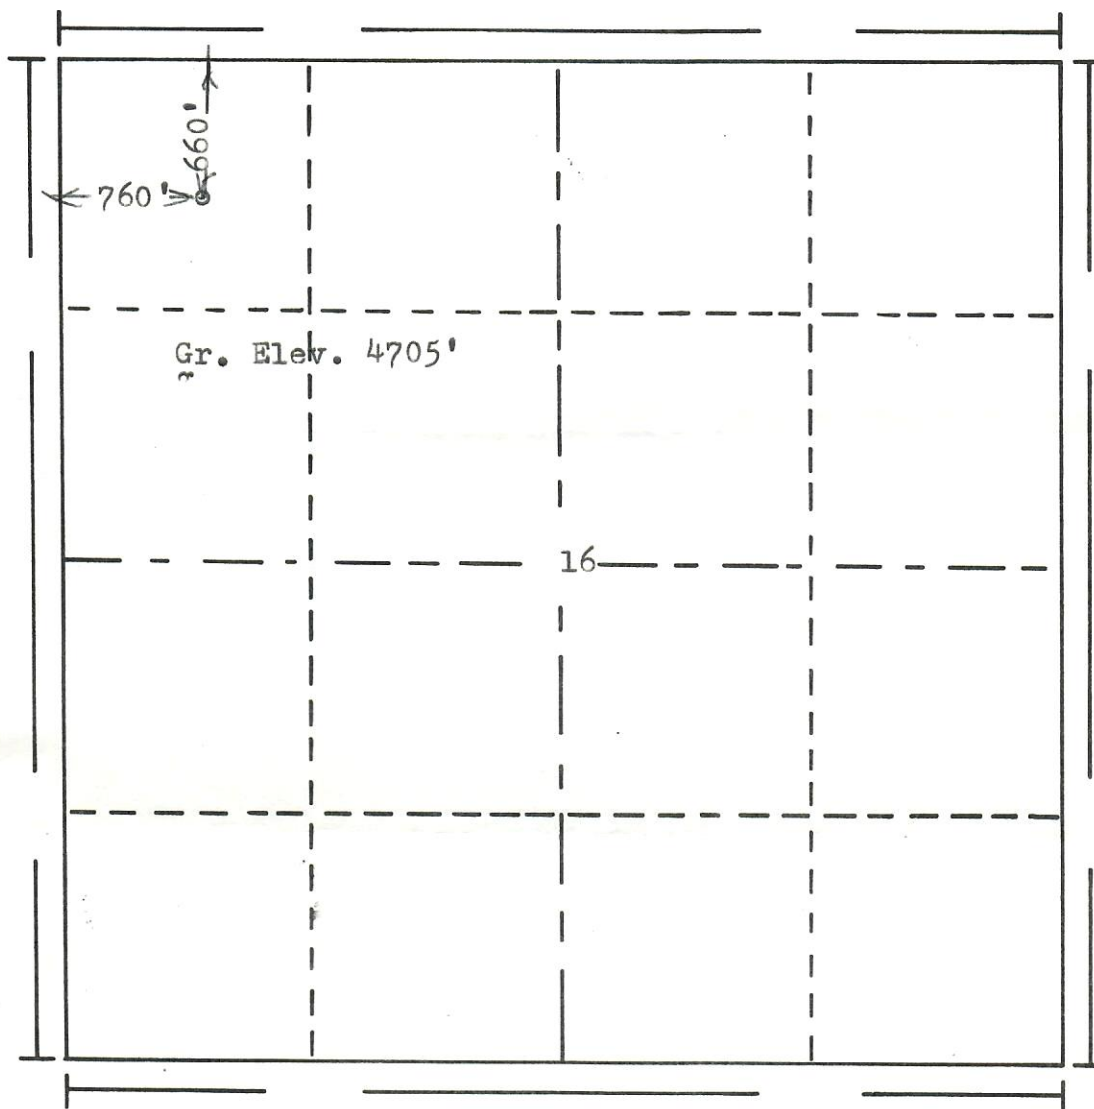T.
3
S

Scale... 1" = 1000'


Powers Elevation of Denver, Colorado

has in accordance with a request from Mr. Davis
for Keba Oil & Gas Co.

determined the location of No. 11X-16 State
to be 660' FN & 760' FW

Range 55W of the 6th Principal Meridian
Washington County, Colorado

I hereby certify that this plat is an
accurate representation of a correct
survey showing the location of

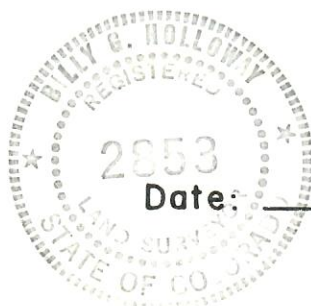

Date: 1-7-82

Billy G. Holloway
Licensed Land Surveyor No. 2853
State of Colorado

VERBAL REQUEST

NOTICE OF INTENTION TO DRILL ✓

Bonding Status _____

NOTICE OF INTENTION TO ABANDON _____

OTHER _____

COMPANY Kebe Oil & Gas Co. ADDRESS _____

BY Charles Davis PHONE NO. 458-1976
Title Extension

WELL NO. 11 X-16 LEASE State

COUNTY Wash. FIELD WC

Location NW NW Sec. 16 Twp. 35 Range 55W Meridian

660 feet from N Section line, and 760 feet from W Section Line
N or S E or W

ESTIMATED DATE OF WORK 1/17/82 est. ESTIMATED TIME _____

DETAILS OF PLAN OF WORK: T.D. 5000' FORMATION J

SURFACE CASING 100' 8 5/8"

Lease: N 1/2 sec. 16

J' sand test

APPROVED BY H H M DATE _____

55W

x			
	16		

35