




R. 55W

RECEIVED

JUN 18 1971

COLD. OIL &amp; GAS CONS. COMM.

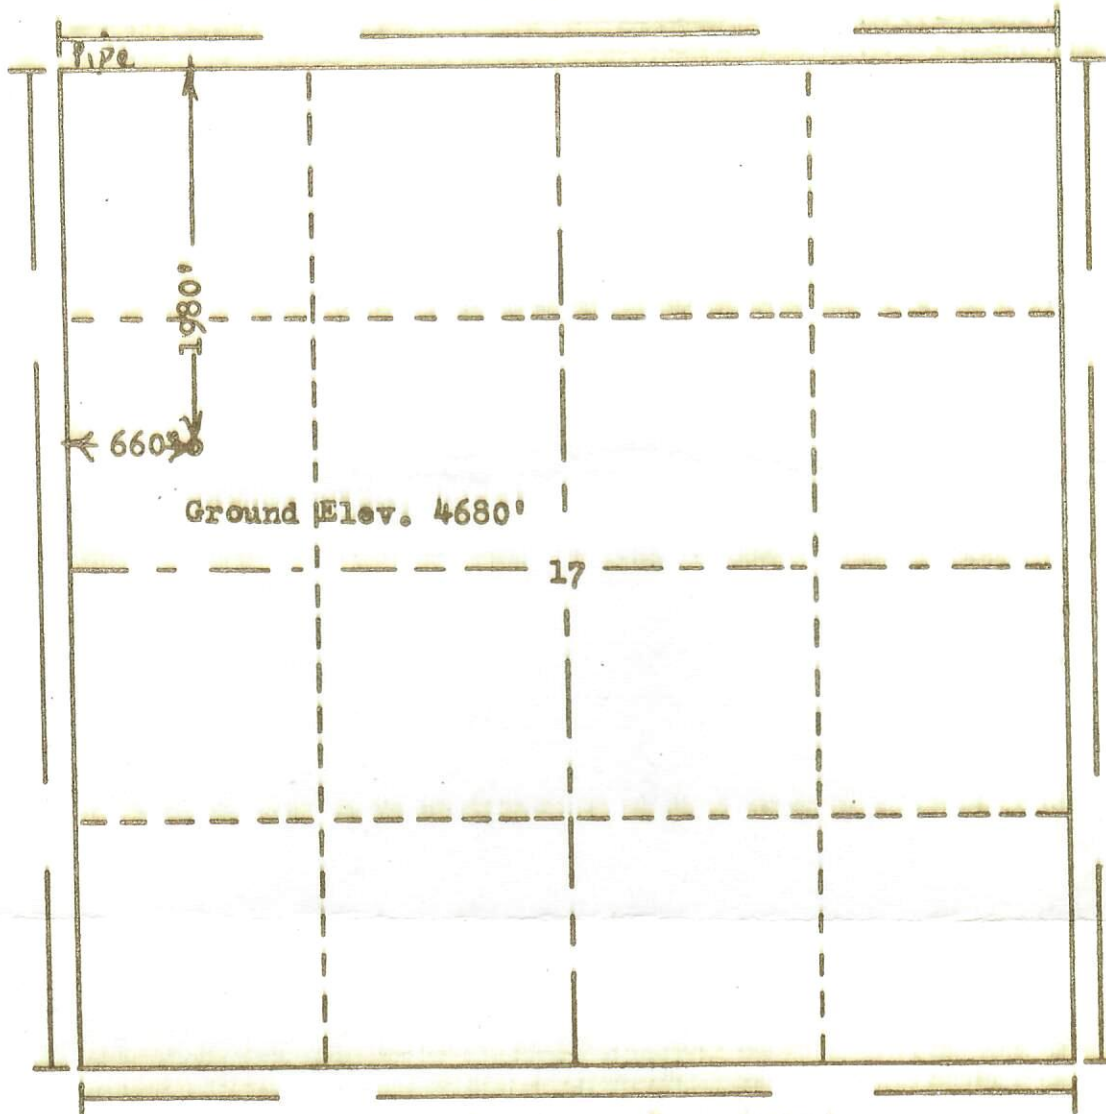

Scale... 1" = 1000'

Powers Elevation Company, Inc. of Denver, Colorado  
 has in accordance with a request from Mr. Scott  
 for Champlin Petroleum Co.  
 determined the location of No. 1 C.L. Jolly 12-17 (3-55)  
 to be CSW NW Section 17 Township 35  
 Range 55W of the 6th Principal Meridian  
 Washington County, Colorado

I hereby certify that this plat is an  
 accurate representation of a correct  
 survey showing the location of

Date: 6-14-71

*Brie G. Hallen*  
 Licensed Land Surveyor No. 2853  
 State of Colorado

71-424