

CERTIFICATE OF SURVEY

For

Kimbark Exploration Co., Tiddens Petr. Corp., and J.B. Ladd
Washington County, Colorado


RECEIVED
JUL 20 1965

OIL & GAS
CONSERVATION COMMISSION



00834445

T35 R56W 6PM

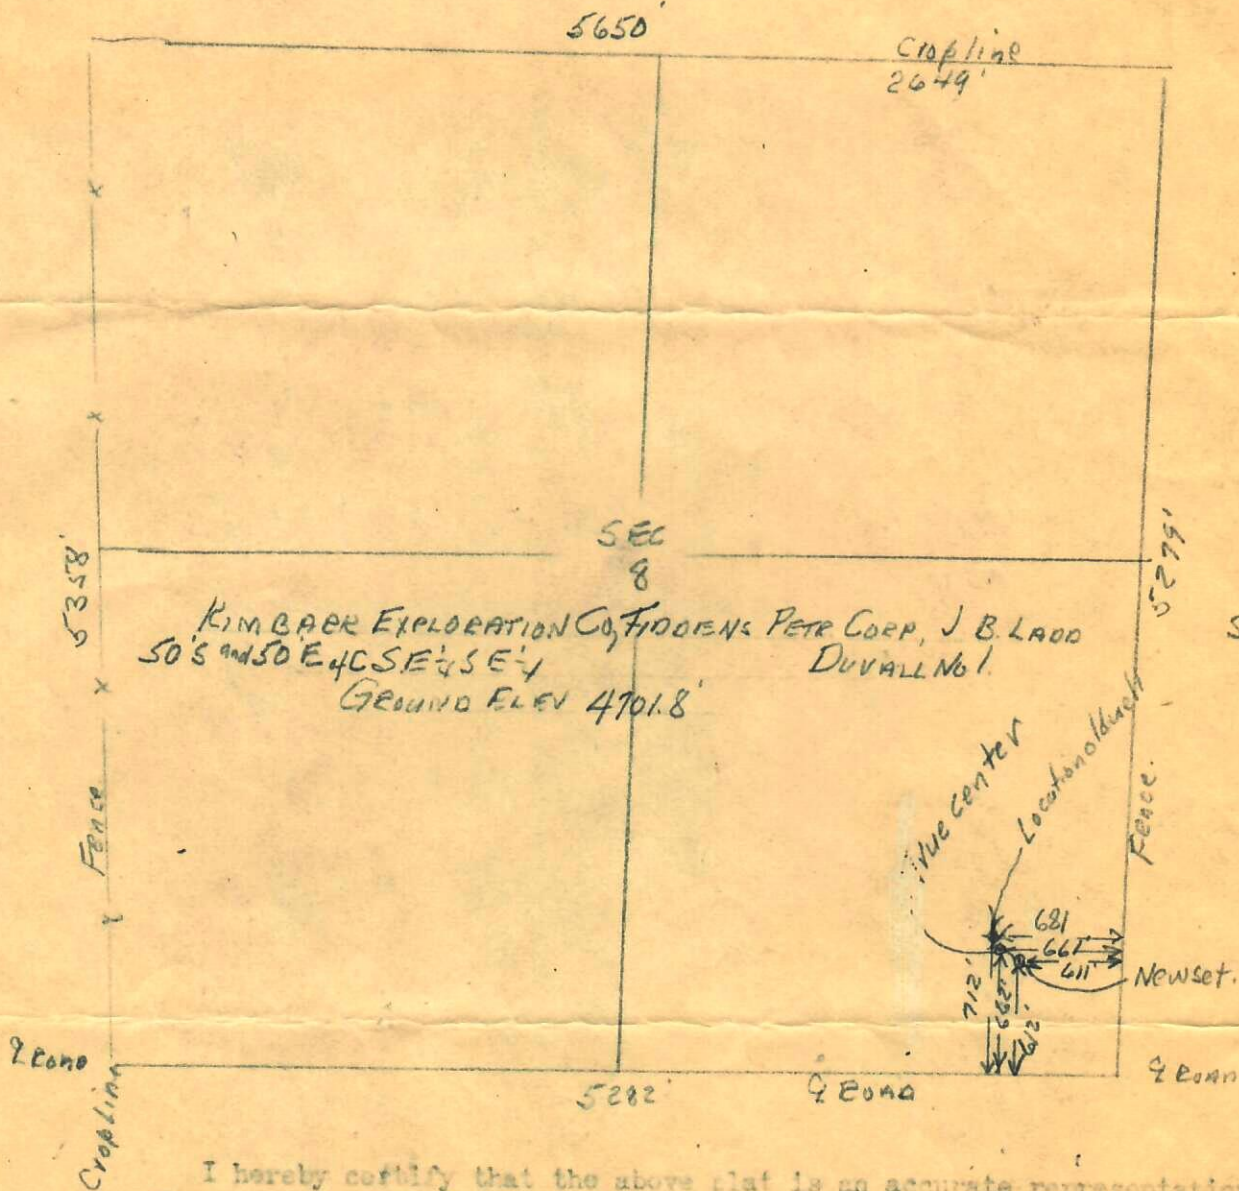

SCALE 1"=1000'

I hereby certify that the above plat is an accurate representation of a correct survey showing the location of Kimbark Exploration Co., Tiddens Petr. Corp., and J.B. Ladd- Duvall No. 1 Oilwell 50 feet south and 50 feet east of the C 3N 1SE1 Sec. 8 T35 R56 W 6PM. The elevation of the ground is 4709.1 feet above sea level from U.S.C.G.C. Bench Mark.

Fort Morgan, Colorado
July 18, 1965

Bevilacqua
Registered Professional Engineer
State of Colorado

65-260