


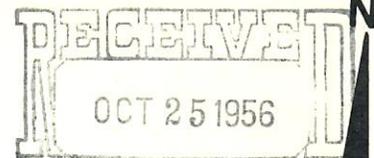


00325686

R. 55 W.



OIL & GAS CONSERVATION COMMISSION

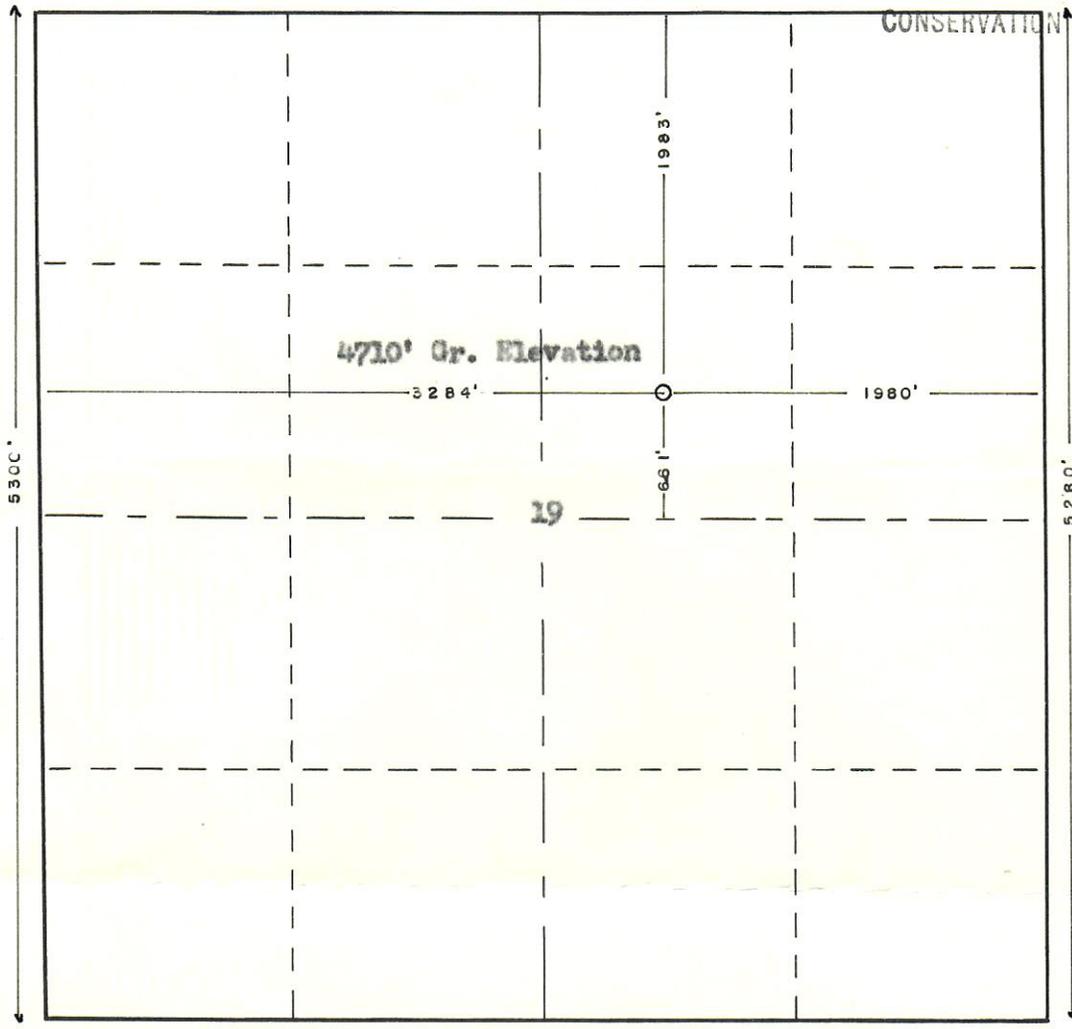

T. 3 S.

Scale... 1" = 1000'

Powers Elevation Company of Casper, Wyoming
 has in accordance with a request from Mr. Marshallman
 for Chicago Corporation & Republic Nat. Gas determined the
 Location of #1 Frank ~~Banker~~ *Landaker*
 to be C SW NE Section 19 Township 3 South,
 Range 55 West 6th Principal Meridian
 Washington County, Colorado.

The above Plat shows the location of the well site
 in said section.

Powers Elevation Company

by: *Burr Leibert*

Date: 10-15-56

Registered Land Surveyor
 Burr Leibert

