


C-696(1)

CERTIFICATE of SURVEY

For  
THE CHICAGO CORPORATION  
#1 Oscar Landaker




00834392

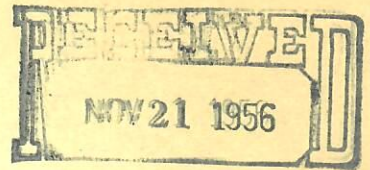

LOCATION: C-NW $\frac{1}{4}$  SE $\frac{1}{4}$  Section 19 T-3-S, R-55-W

ELEVATION: 4720 Gr. OIL & GAS  
CONSERVATION COMMISSION

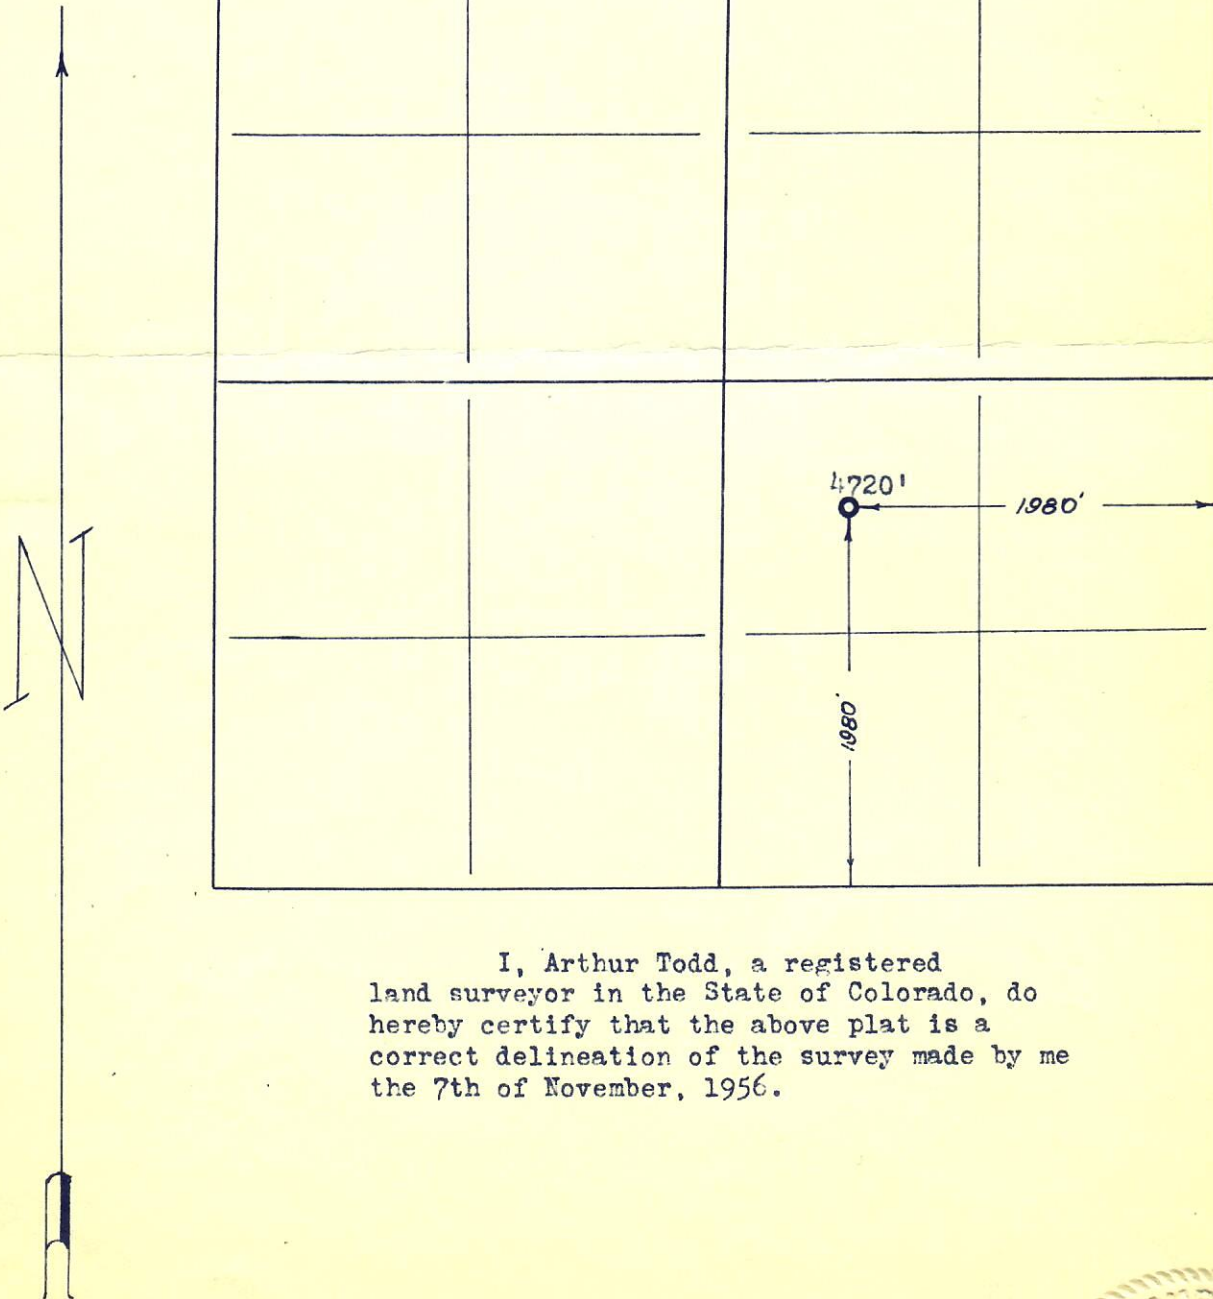

I, Arthur Todd, a registered  
land surveyor in the State of Colorado, do  
hereby certify that the above plat is a  
correct delineation of the survey made by me  
the 7th of November, 1956.

TODD ENGINEERING CO.  
4380 Wadsworth  
WHEAT RIDGE, COLO.

