



Interoffice OGCC-1  
Rev. 9-23-66


VERBAL REQUESTS

NOTICE OF INTENTION TO DRILL X

Bonding Status Blanket

NOTICE OF INTENTION TO ABANDON \_\_\_\_\_

OTHER \_\_\_\_\_

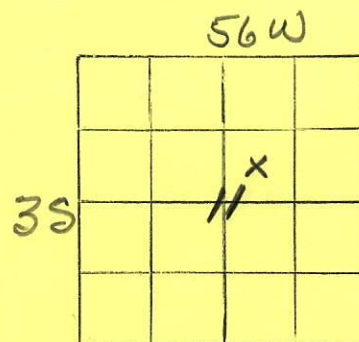

COMPANY Chandler & Assoc. Inc. ADDRESS \_\_\_\_\_

WELL NO. 1 BY Mrs. Zell PHONE NO. 722-7911  
Extension \_\_\_\_\_

LEASE Downing TITLE Sec.

COUNTY Wash. FIELD w/c

Location SW NE Sec. 11 Twp. 3 S Range 56W Meridian \_\_\_\_\_  
(Quarter-Quarter)

1984 Feet from 5 Section line and 1980 feet from E Section line  
N or S E or W

G.L. 4770'

ESTIMATED DATE OF WORK Dec. 22, 1966 ESTIMATED TIME \_\_\_\_\_

DETAILS OF PLAN OF WORK: T.D. 5250 FORMATION J

SURFACE CASING 8 5/8" - sufficient 100'

Drill by Exeter

J sand test

APPROVED BY: H. H. Monnell

DATE: 12/20/66

✓