




OIL AND GAS CONSERVATION COMMISSION OF THE STATE OF COLORADO

NOTICE OF INTENTION TO DRILL

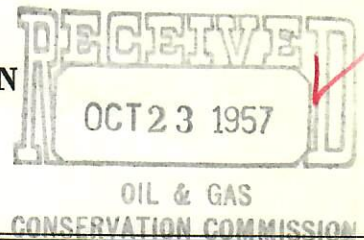


INSTRUCTIONS:

A notice of intention to drill a well shall be filed in duplicate on all Federal and Patented lands, and in triplicate on all State lands. Do not begin operations until approved copy has been received. It is mandatory that the proposed location comply with all rules and regulations of the Commission. Locate well on section grid in proper location, and indicate extent of lease. Unless operations are commenced within 180 days after the date of approval hereof, this approval to drill will become null and void.

Name of Operator Colorado-Southern Petroleum Corp. Phone No. TA 5-1221
Address 226 Patterson Building City Denver State Colorado

How is liability secured: Well Bond (Attached) ☐; Blanket Bond ☐; Waiver ☒
(Check one)

Lease Name Schreiber
Well No. 1
Field Name West Fork Wildcat ☐
County Washington

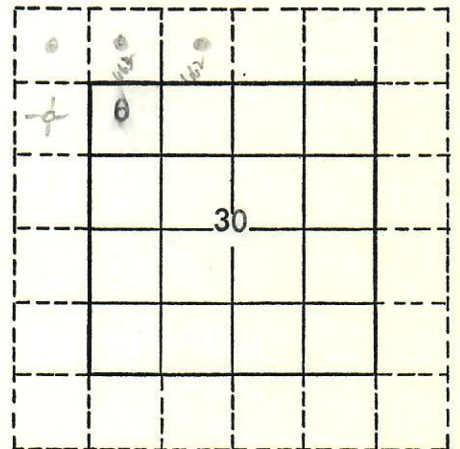

Location NW/4 NW/4 Section 30 Township 3-S Range 55-W Meridian 6th PM
(quarter quarter)
660 feet from N Section line and 660 feet from W Section Line

The well is located on: Patented land ☒ State land ☐ Federal land ☐

The well is located within a spaced area: Yes ☒ No ☐

Distance from proposed location to nearest property or lease line 660 feet.
Distance from proposed location to nearest drilling unit line 660 feet.

Objectives: "D" Formation Depth 4850' Estimate; "J" Formation Depth 4900 Estimate

Proposed length of surface casing 150 feet.

REMARKS:

Agent	
Bond	
Spot	
800 ft.	
1200 ft.	
Wells	
Oil	
Gas	
Status	

BEST COPY AVAILABLE

I/We hereby swear (or affirm) that the statements herein made are a full and correct report.

APPROVED: OCT 23 1957

Date
A. J. Jensen
Director

Company COLORADO-SOUTHERN PETROLEUM CORP. Date 10-22-57
Address 226 Patterson Building Phone No. TA 5-1221
By San Benson Title President
Signature